

G-6580  
47817


RECEIVED

OCT - 6 1975

WATER RESOURCES DEPT.  
SALEM, OREGON

T.38&39S. R.11W. W.M

Shoat Piner wells

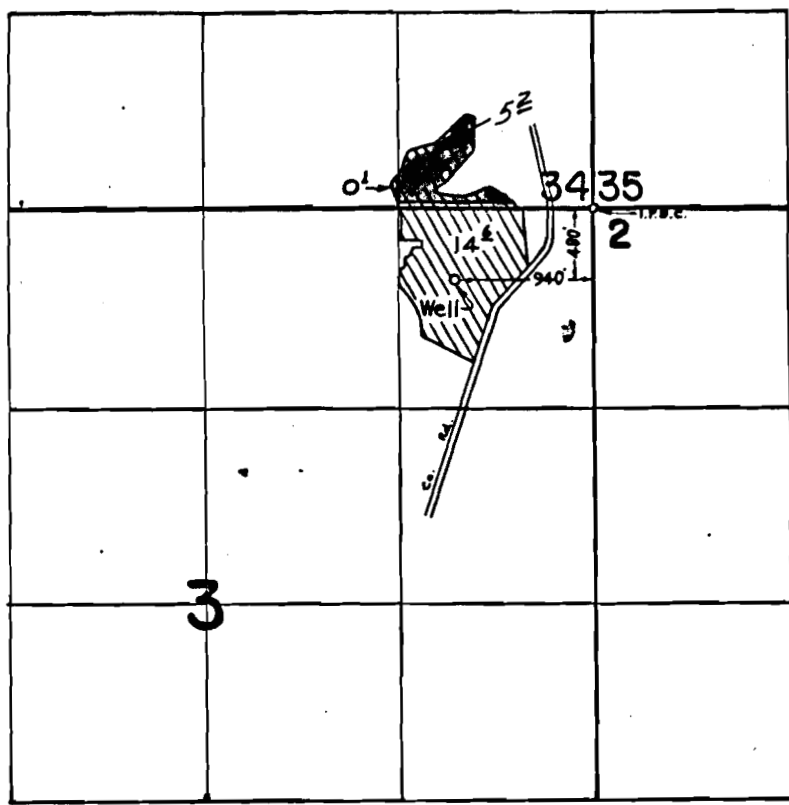

Application No. G-7128

Permit No. G 6580

FINAL PROOF SURVEY  
UNDER

Application No. G-5276 Permit No. G-5119  
IN NAME OF

HOWARD T. KELLISON

Surveyed OCT. 24, 1974, by L.E. GOULD