


6-5182  
47818

T.37S. R.14E. W.M.

S.K. Sprague Bv. Wells

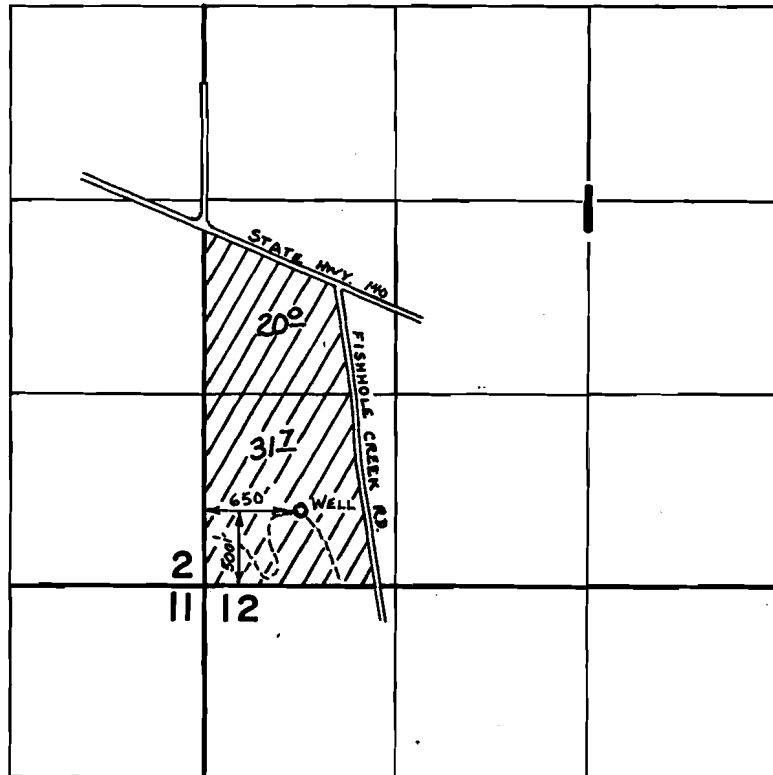

**FINAL PROOF SURVEY**  
UNDER

Application No. G-6052 Permit No. G-5182  
IN NAME OF

DONALD R. & SHARON R. WESSEL

Surveyed AUG. 20 1977., by D. NORBY.....