


G-6554
47820

T.26S. R.15E., W.M.

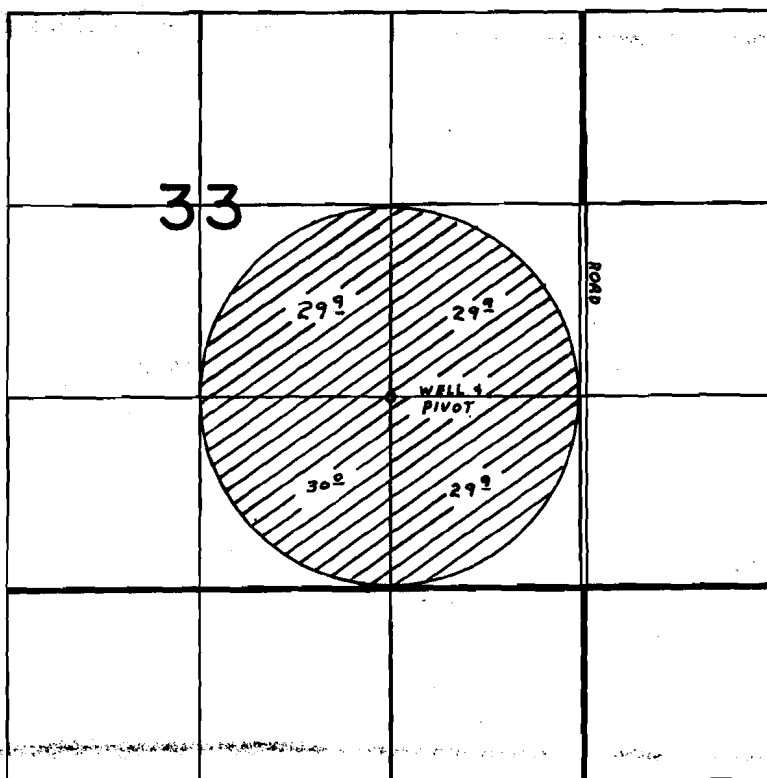

WELL LOC. 1320' N. & 1320' W. FROM S.E. COR. SEC. 33

FINAL PROOF SURVEY
UNDER

Application No. G-7085 Permit No. G-6554
IN NAME OF

FIRST NATIONAL BANK OF OREGON

Surveyed JUL 16, 1977, by D.M. NORBY