


T.16S.,R.2E.,W.M.

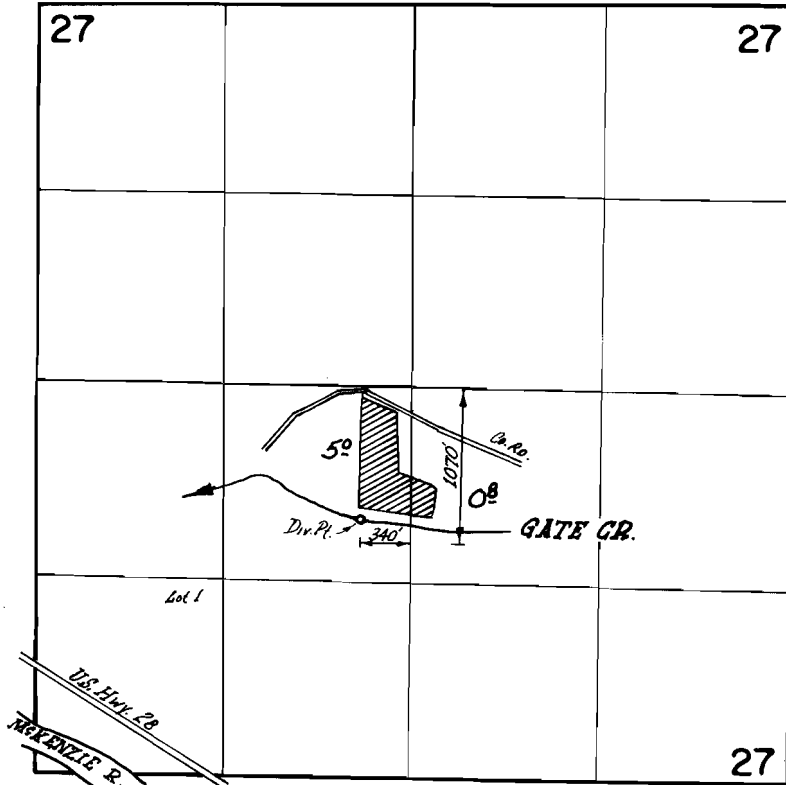

FINAL PROOF SURVEY
UNDER

Application No. 48431 Permit No. 36355
IN NAME OF

JOHN C. & MARION O'LEARY

Surveyed Aug. 22 1974 by L.H. Nunn
Aug. 18 1977 L.M. Toll