


T17S. R1E. WM.

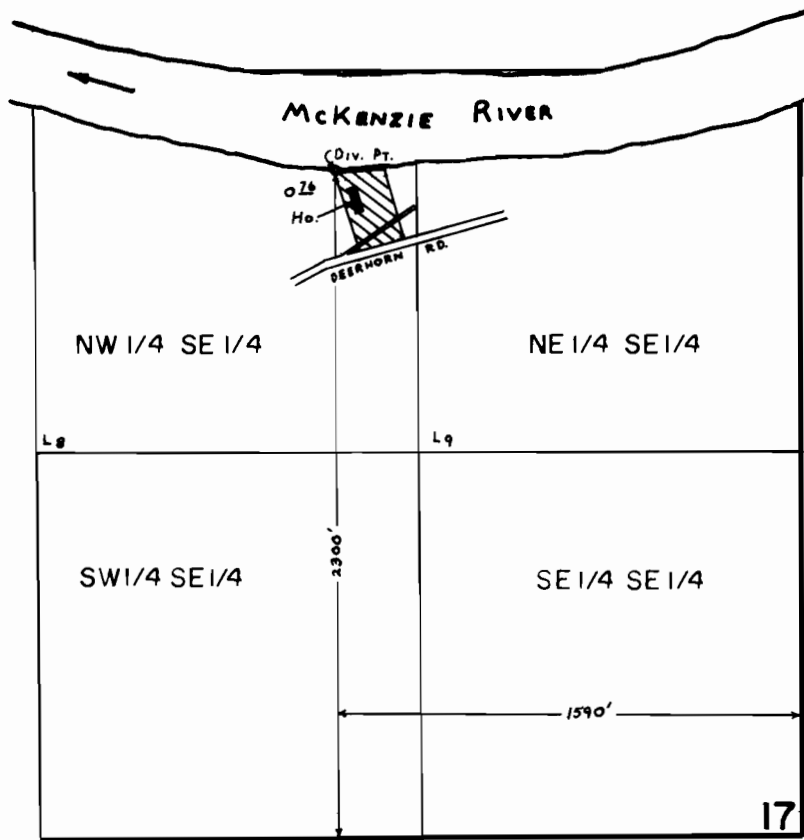

SCALE: 1 INCH = 10 CHAINS = 660 FEET

FINAL PROOF SURVEY UNDER

Application No. 50772 Permit No. 38342
IN NAME OF

Joseph E. Marton

Surveyed JULY 18 1978, by C. L. HUGHES