


T.16S. R.2E. W.M.
SEC. 34

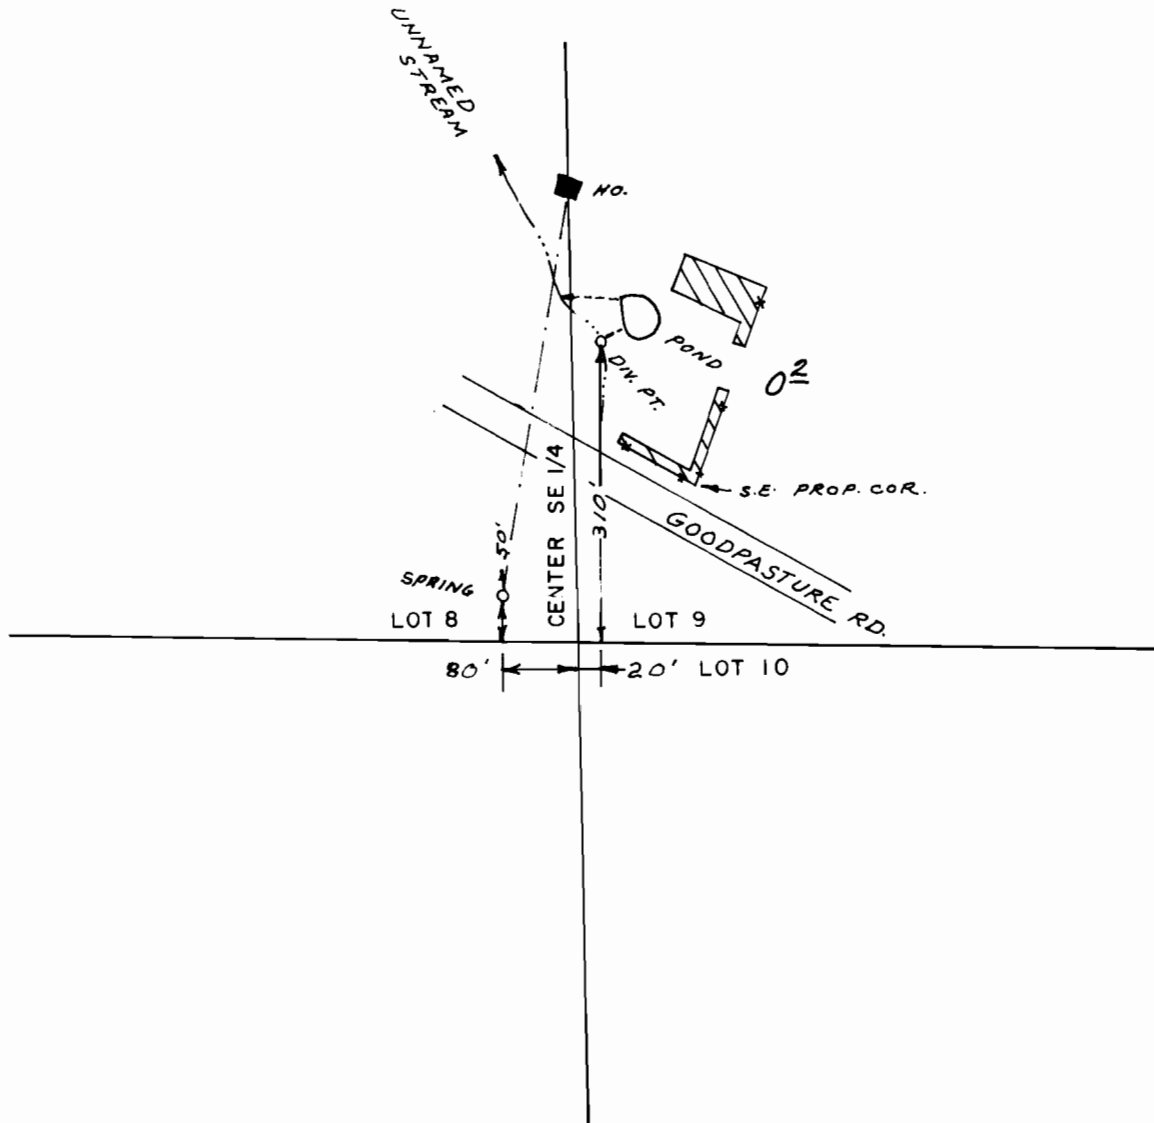

SCALE 1" = 200'

FINAL PROOF SURVEY
UNDER

Application No. 51934... Permit No. 37743...
IN NAME OF

ROBERT ALAN CARMICHAEL, D.D.S.

Surveyed AUG. 31. 1977, by L.H. NUNN