


T6S., R. 11W., W.M.

SEC 25

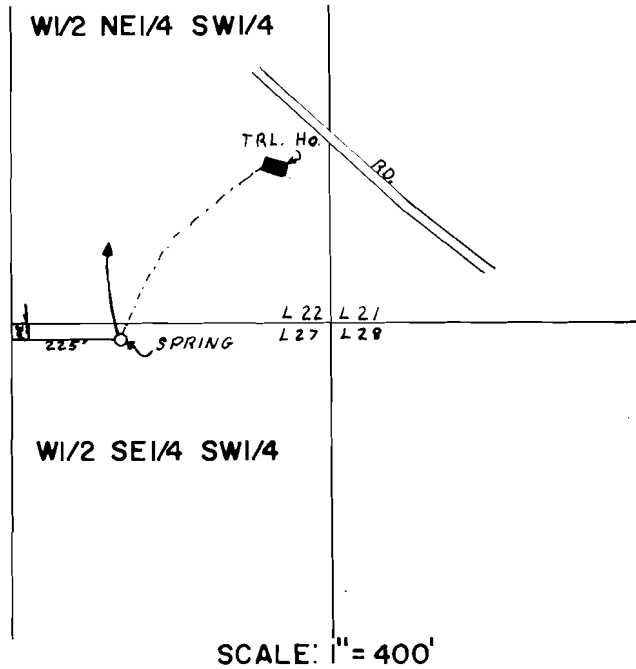

FINAL PROOF SURVEY UNDER

Application No. 45815 Permit No. 34187
IN NAME OF

BYRON L. & GEORGIA L. RUSSELL

Surveyed JULY 1, 1976, by C.R. KING