


T.15S. R.11W. W.M.

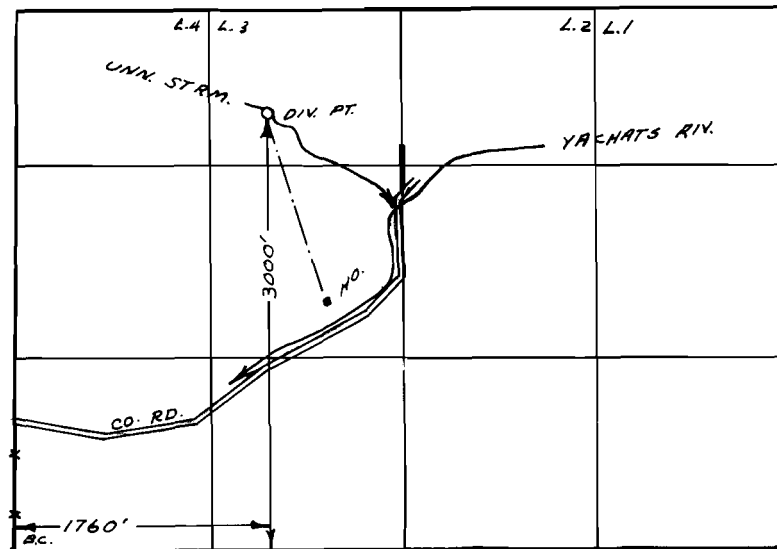

FINAL PROOF SURVEY
UNDER

Application No. 54473... Permit No. 40861...
IN NAME OF

DOUGLAS & MARION ASCHE

Surveyed SEP. 29. 1977, by L.H. NUNN