


T.12S., R.4 & 5W., W.M.

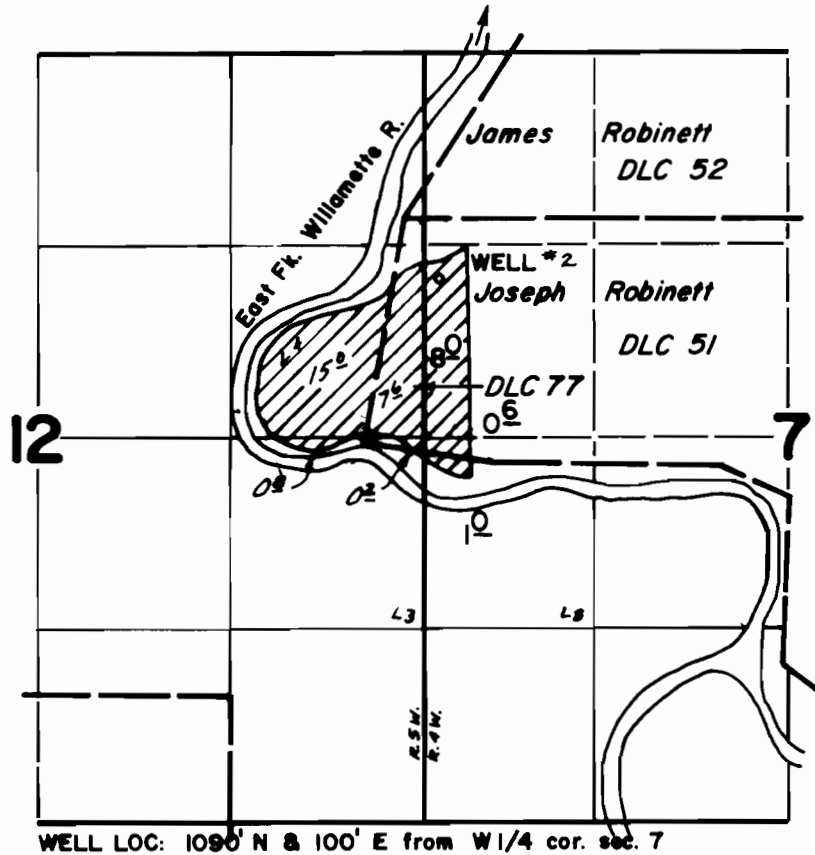

FINAL PROOF SURVEY UNDER

Application No. G-6242 Permit No. G-5887
IN NAME OF

WILLARD A. & BETTY A. HAMLIN

Surveyed April 13 1976, by D. Norby