


T. IIS. R. 2W. W.M.

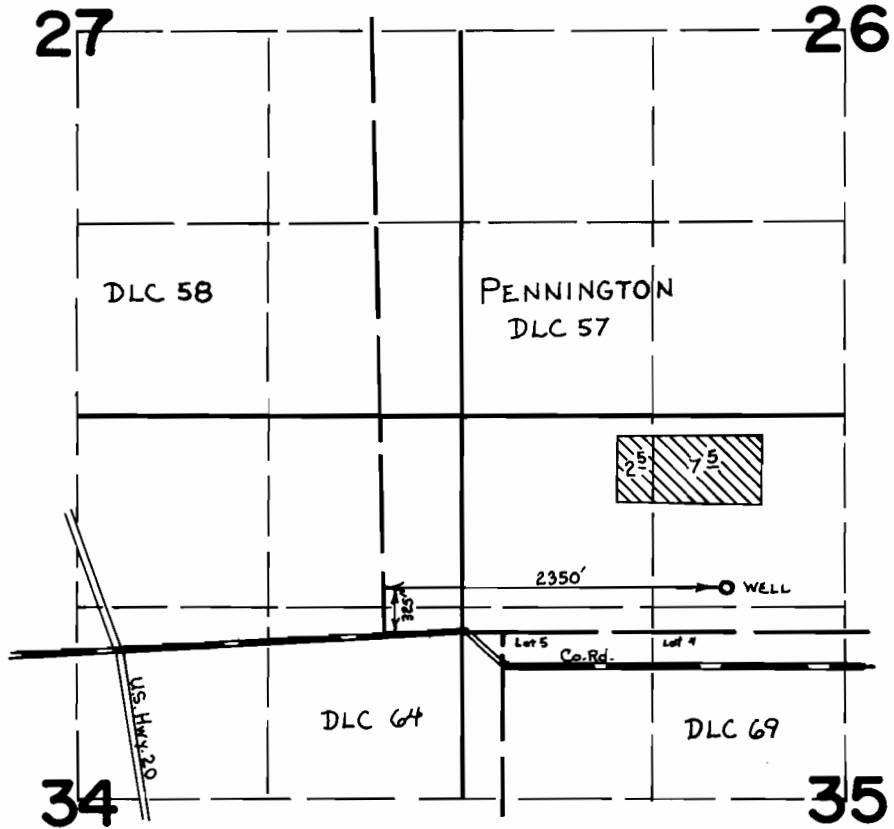

FINAL PROOF SURVEY
UNDER

Application No. G-6904 Permit No. G-6430
IN NAME OF

ROBERT F. MEYER

Surveyed AUG. 8, 1977, by D. NORBY