


T. 16S., R. 43E., W.M.

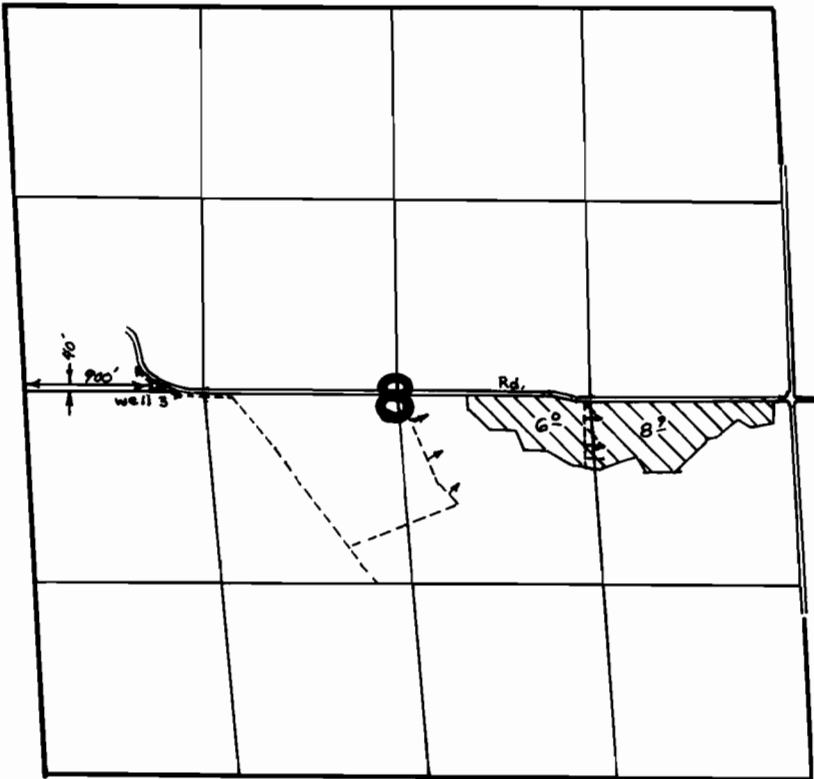

**FINAL PROOF SURVEY**  
UNDER

Application No. G-5636 Permit No. G-6722  
IN NAME OF  
GUM CREEK FARMS, INC. and  
KANSAS CITY LIFE INS. CO.

Surveyed OCT. 14, 1977, by J.S. DONALDSON