


T.4 & 5S. R.1 W., W.M.

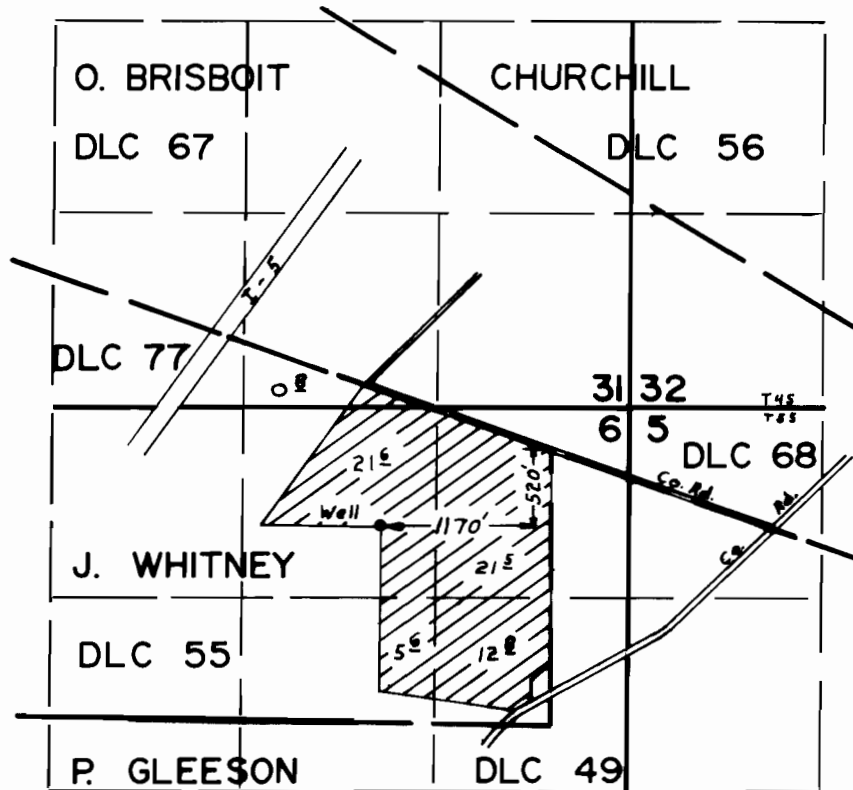

FINAL PROOF SURVEY UNDER

Application No. G-5986.. Permit No. G-5669..
IN NAME OF

.....PAUL E. WANNER.....

Surveyed AUG..17.. 1977., by B.R. SUND.....