T. 6S. R. 2W. W.M.

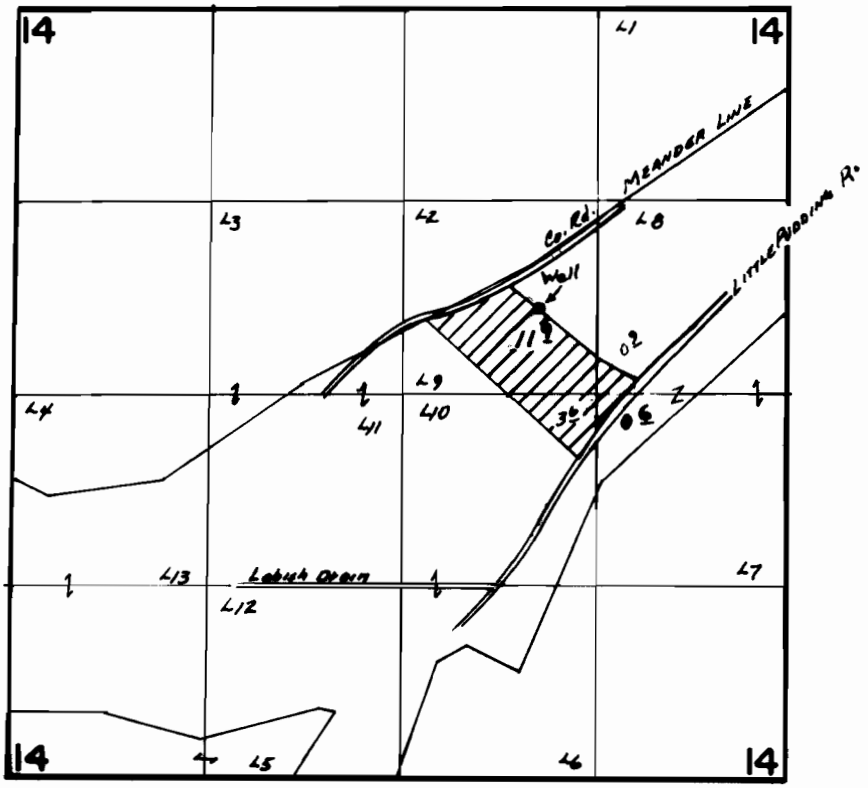

Well Loc. - 590'N & 1766'W From E¼ Cor. Sec. 14

FINAL PROOF SURVEY
UNDER

Application No. G-6035 Permit No. G-5216
IN NAME OF

Estate of EDWARD HYNES

Surveyed April 15, 1977, by L. H. NUNN

DFN-6LL-203