


# T.6 & 7S. R.2W. W.M.

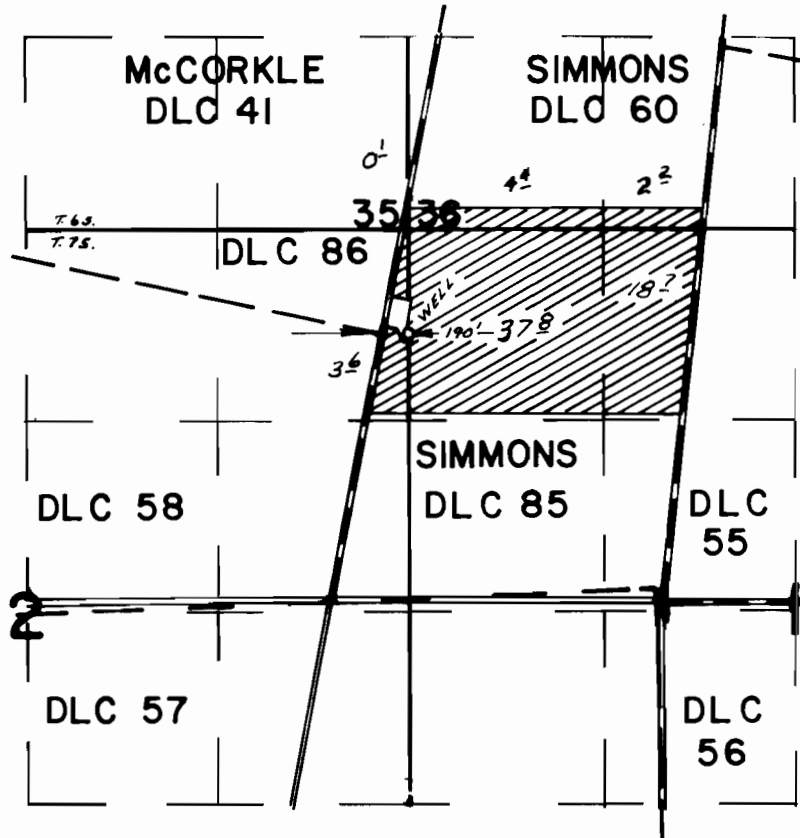

## FINAL PROOF SURVEY UNDER

Application No. G-6141... Permit No. G-5833...  
IN NAME OF

CLARENCE. SIMMONS

Surveyed OCT. 4... 1977, by L.H. NUNN.....