


# T.6S.,R.2W.,W.M.

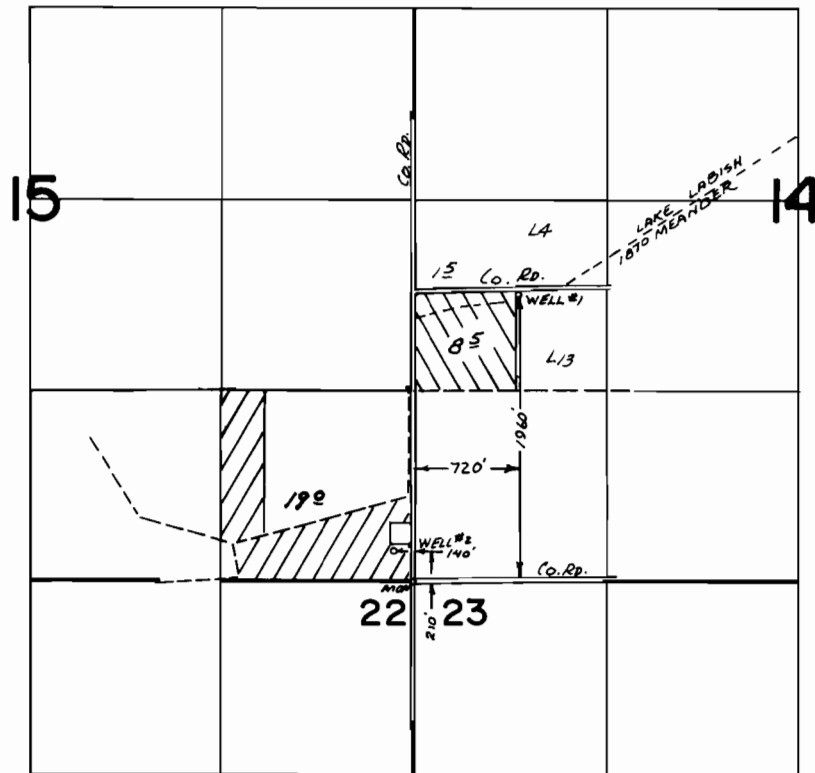

## FINAL PROOF SURVEY UNDER

Application No. G-6318 G-5934  
G-6522 Permit No. G-6133   
IN NAME OF

SAM RAMP

Surveyed APRIL 22 1976, by L. Toll  
JUNE 4, 1976 L. Toll