


T.6S.,R.2W.,W.M.

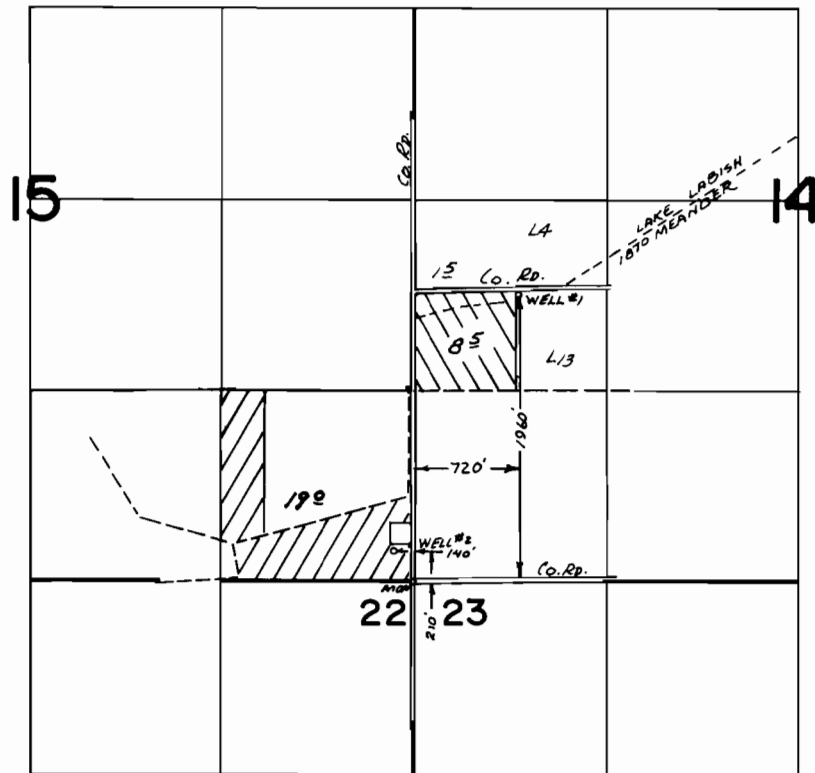

FINAL PROOF SURVEY UNDER

Application No. G-6318 Permit No. G-5934 
G-6522 G-6133
IN NAME OF

SAM RAMP

Surveyed APRIL 22 1976, by L. Toll
JUNE 4, 1976 L. Toll