


T.7S. R.2W. W.M.

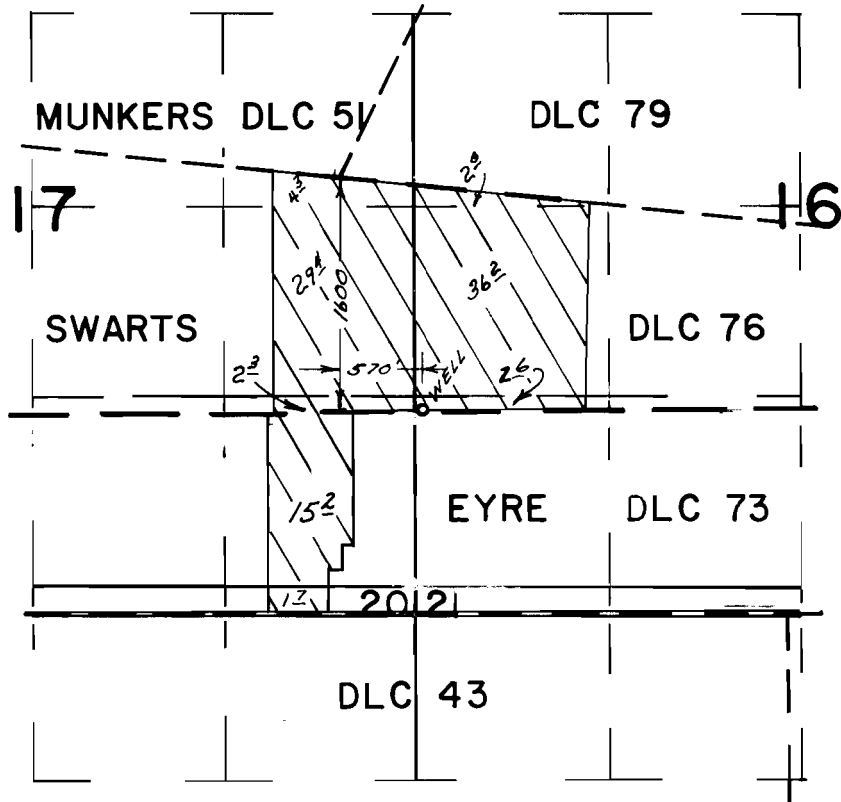

**FINAL PROOF SURVEY**  
UNDER

Application No. G-7040. Permit No. G-6527.  
IN NAME OF

A. EUGENE PETROFF

Surveyed APR. 13. 1977. by L.H. NUNN