


T.6S. R.2W., W.M.

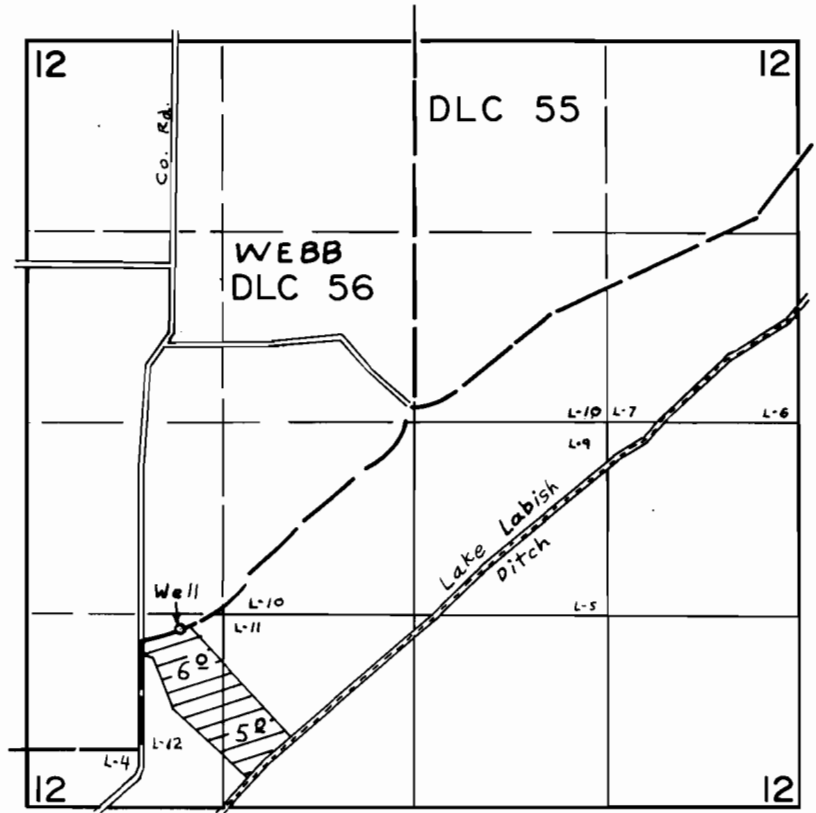

Well Loc. 1230' N & 1050' E FROM S.W. COR. SEC. 12

FINAL PROOF SURVEY UNDER

Application No. G-7163... Permit No. G-6608...
IN NAME OF

..... E. EVELYN BENNETT

Surveyed SEPT. 6, 1977, by B.R. SUND