


T.5S. R.1W., W.M.

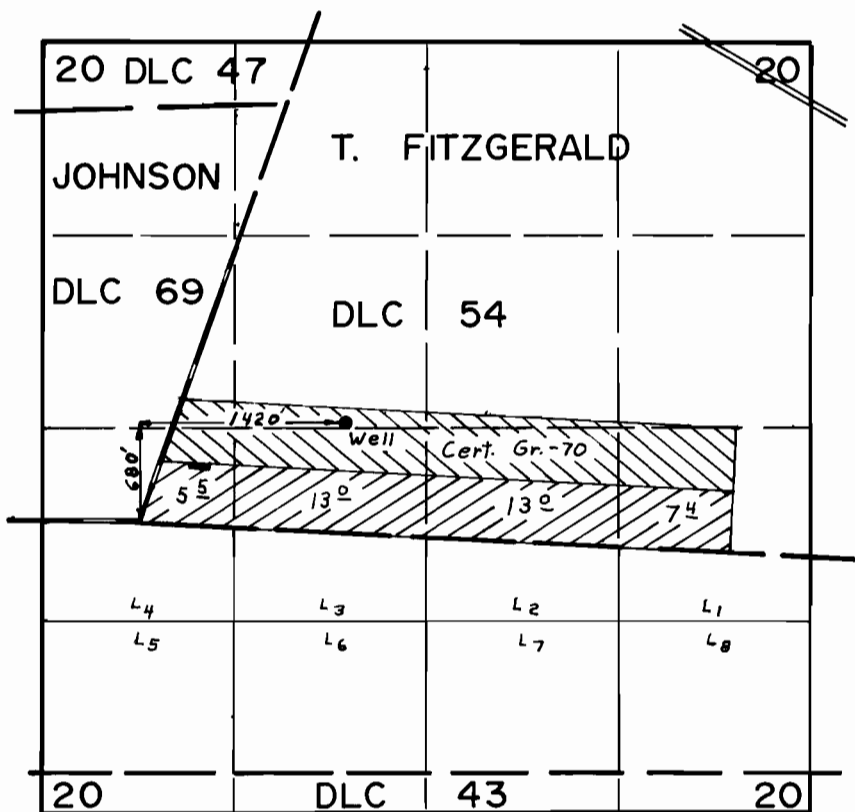

FINAL PROOF SURVEY UNDER

Application No. G-7344. Permit No. G-6806
IN NAME OF

.....NORMAN J. ROBERTS.....

Surveyed AUG. 18. 1977, by B.R. SUND.....