


T.7S.,R.1E.,W.M.

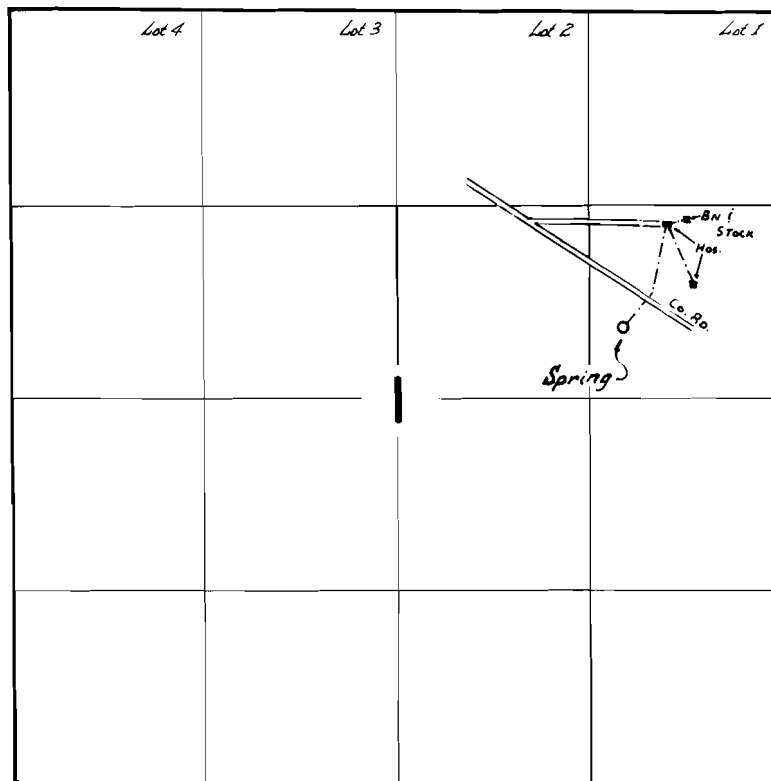

SPRING LOC: 2170'S. & 1540'E. fr. N. $\frac{1}{4}$ COR. SEC. 1.

FINAL PROOF SURVEY
UNDER

Application No. 54065 Permit No. 40434
IN NAME OF

TIMOTHY FENNIMORE

Surveyed Sept. 9 1977, by R.G. Mucken