


T.9S. R.6 W.W.M.

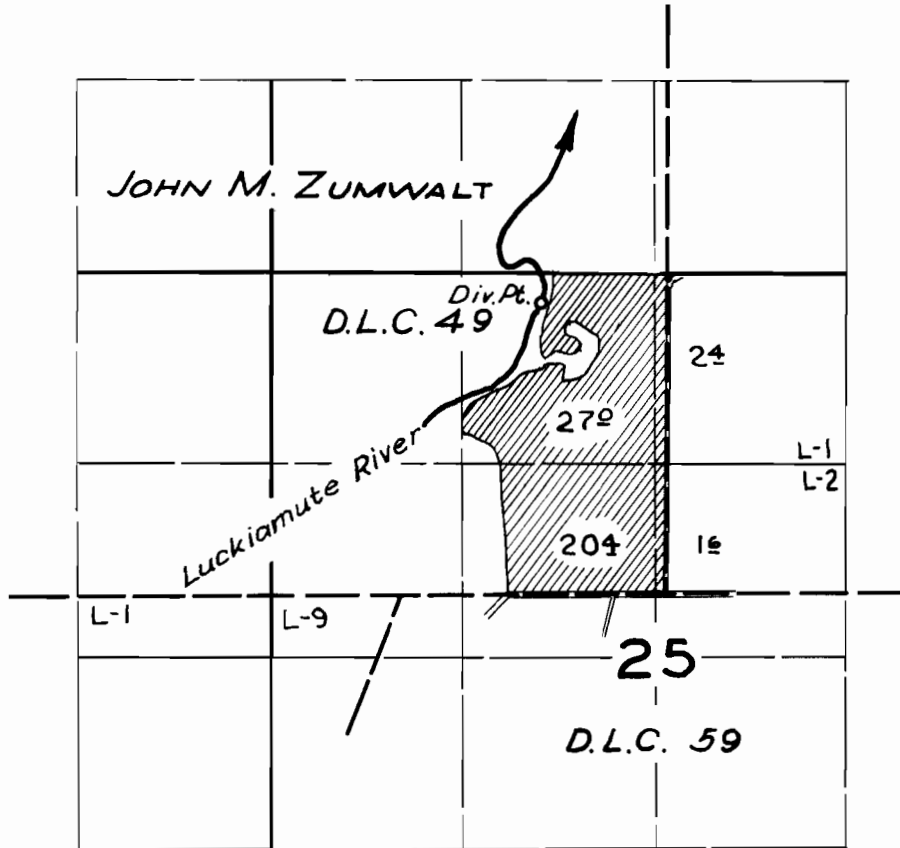

FINAL PROOF SURVEY
UNDER

Application No. 31249... Permit No. 24720
IN NAME OF

VIRGIL L. & FRANCES L. MATHANY

Surveyed May 15, 1958, by R.H. Whitby