


T. 1 S., R. 8 W., W. M.

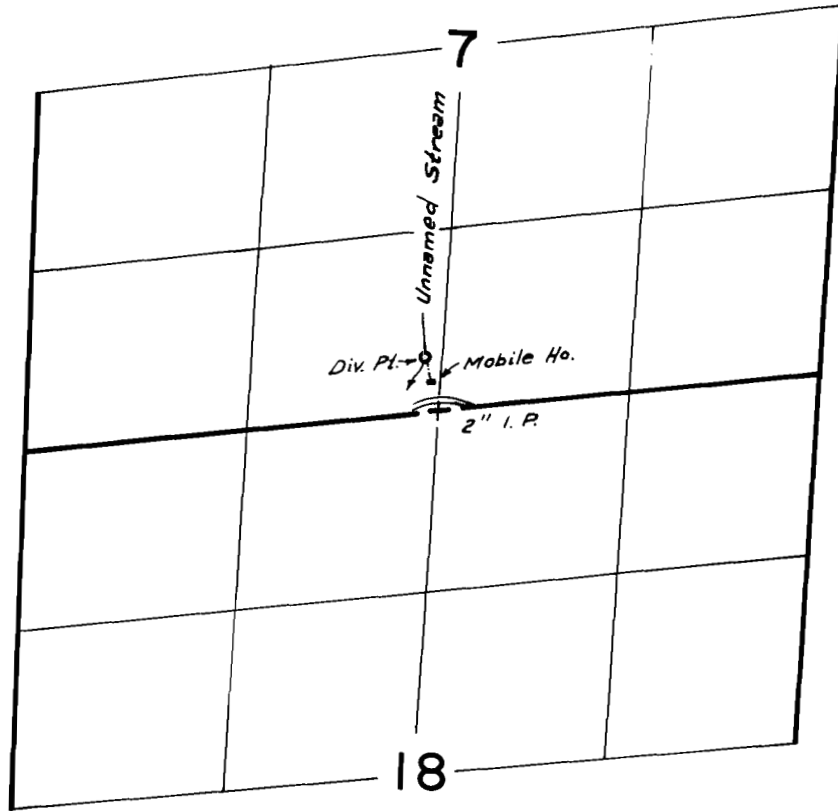

Div. Pt. Loc.: 360' N. & 120' W. from S. 1/4 Cor. Sec. 7

FINAL PROOF SURVEY
UNDER

Application No. 55488 Permit No. 41522
IN NAME OF

Dustin M. Musaraca

Surveyed Sept 28, 1977, by J. L. Brown