


G-6613
478L3

T.6N. R.35E. W.M.

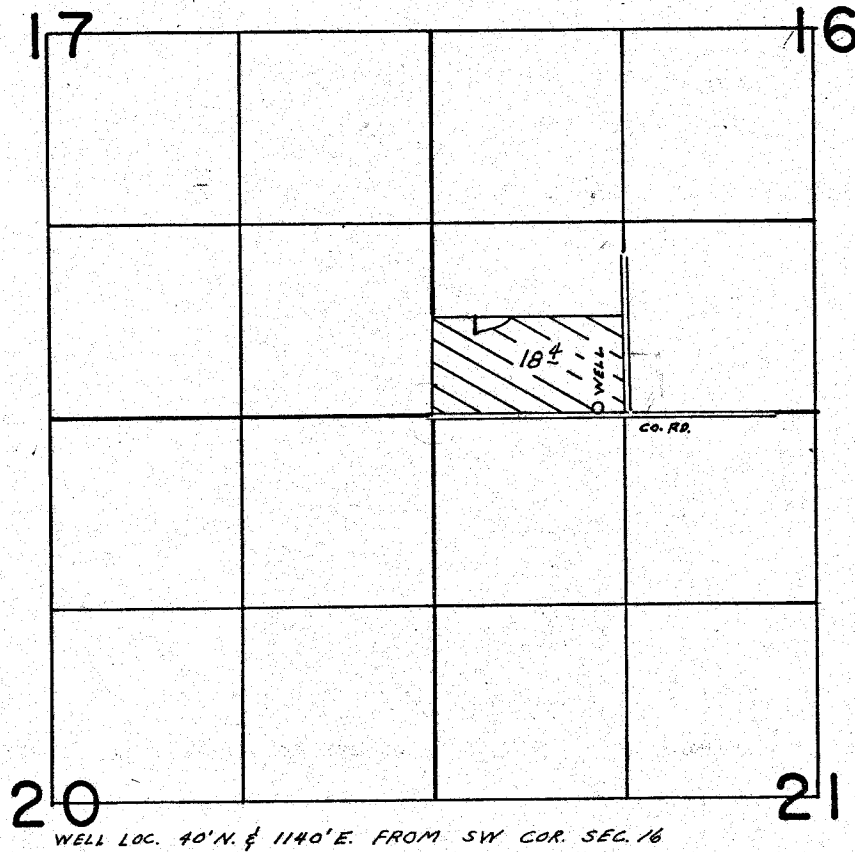

FINAL PROOF SURVEY
UNDER

Application No. G-7178... Permit No. G-6613....
IN NAME OF

NORMAN F. KRALMAN

Surveyed APR. 28. 1977., by L.H. NUNN