


T.5N. R.29E. W.M.

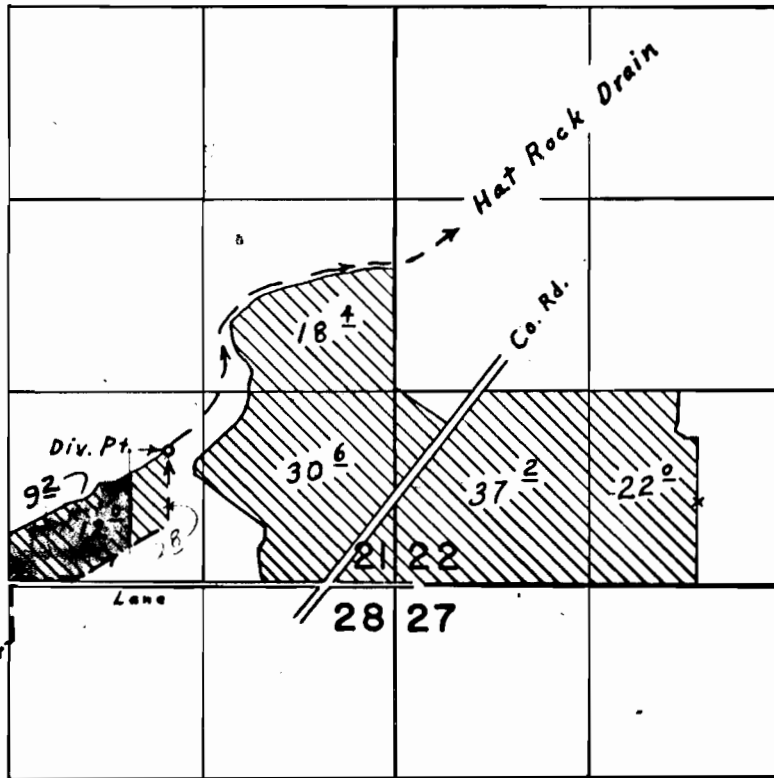

Div. Pt. located 920' N. & 1050' W. from S.E. Cor. Sec. 21

RECEIVED

FEB 13 1975

STATE ENGINEER
SALEM, OREGON

FINAL PROOF SURVEY
UNDER

Application No. 42804 Permit No. 32000
IN NAME OF

STANLEY BASFORD

Surveyed April 18, 1973, by J. E. Gould

Application No. 52779
Permit No. 39726