


T. 1 S. R. 39 E. W. M.

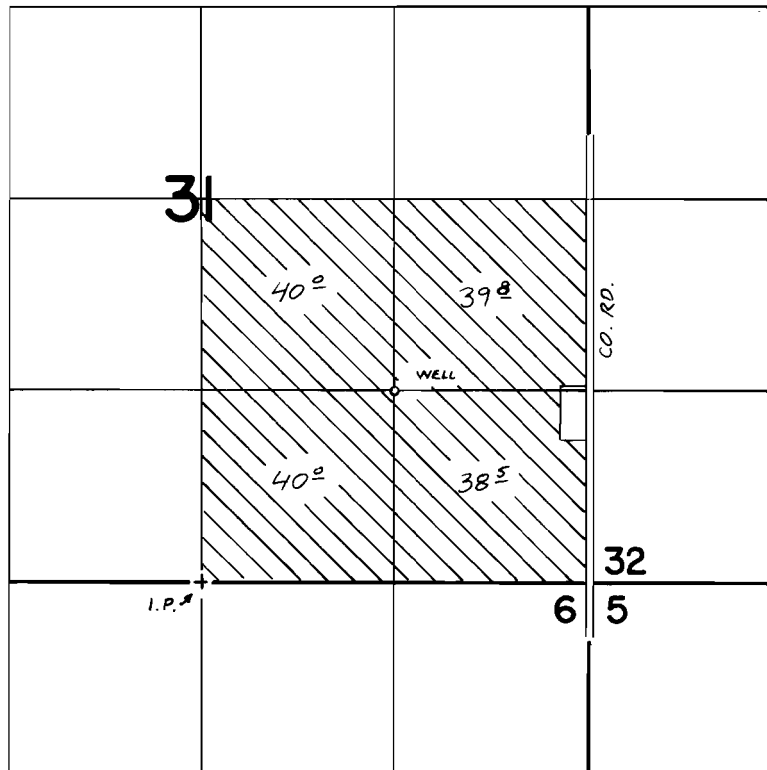

WELL LOCATED 1320' N & 1320' E FROM S 1/4 COR., SEC 31

FINAL PROOF SURVEY
UNDER

Application No. G-6345 Permit No. G-5948
IN NAME OF

CRESTON J. SHAW & RIEN DE LINT

Surveyed OCT. 21, 1976, by L. H. NUNN