


P# 6-5031  
6-5032  
6-5035

T. 4S., R. 12E., W.M.

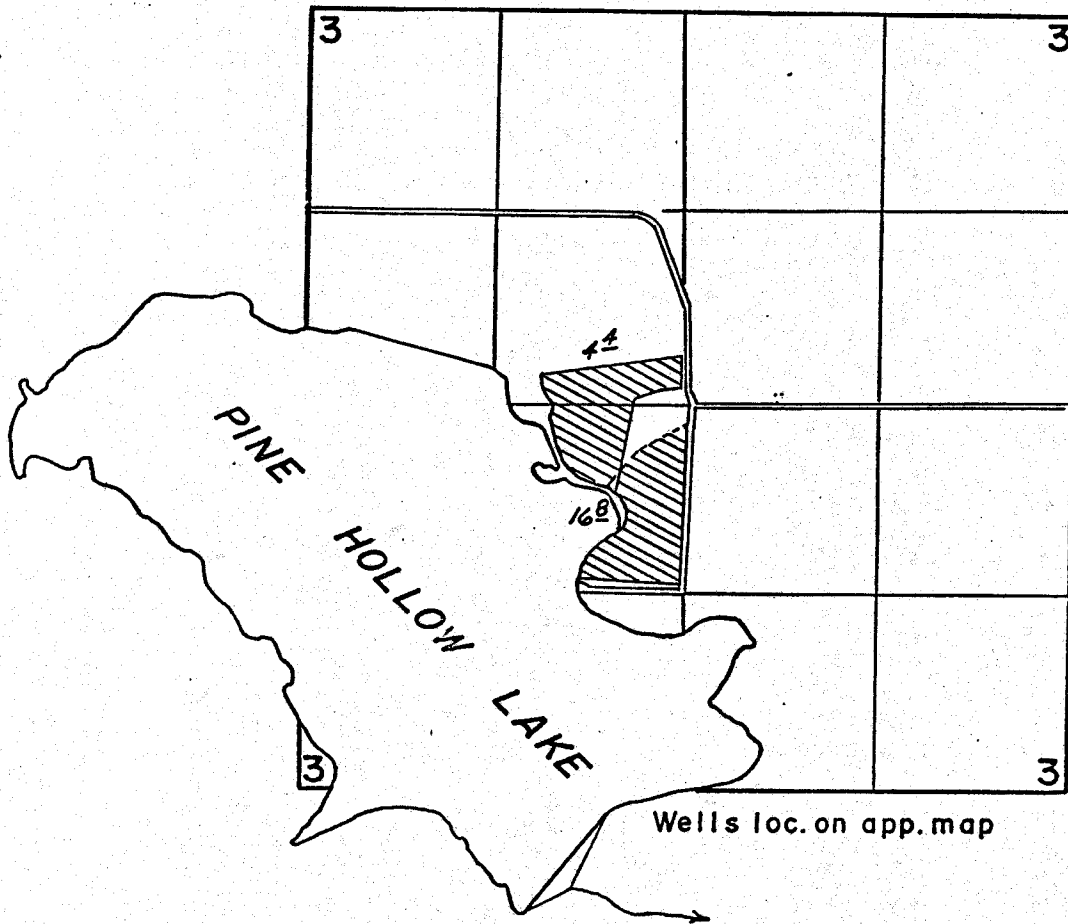

**FINAL PROOF SURVEY**

UNDER  
IRRIGATION PORTION OF

G-5180                      G-5031  
G-5181                      G-5032  
Application No. G-5779.. Permit No. G-5035..  
IN NAME OF

..... IRL DAVIS, JR. ....

Surveyed NOV. 2..... 19.77, by L.H. NUNN.....