


P# G-5031
G-5032
G-5035

T. 4S., R. 12E., W.M.

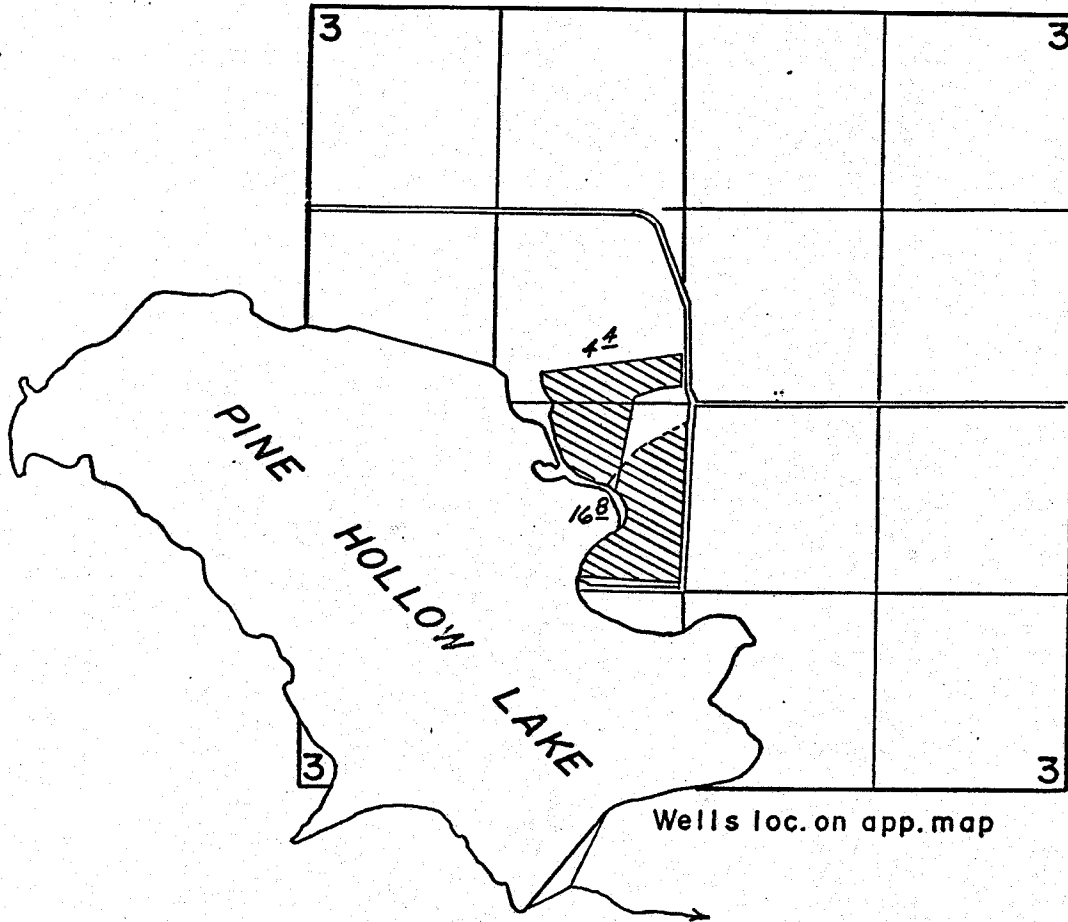

FINAL PROOF SURVEY

UNDER
IRRIGATION PORTION OF

G-5180 G-5031
G-5181 G-5032
Application No. G-5779.. Permit No. G-5035..
IN NAME OF

..... IRL DAVIS, JR.

Surveyed NOV. 2..... 19.77, by L.H. NUNN.....