


T.1N. R.13E. W.M.

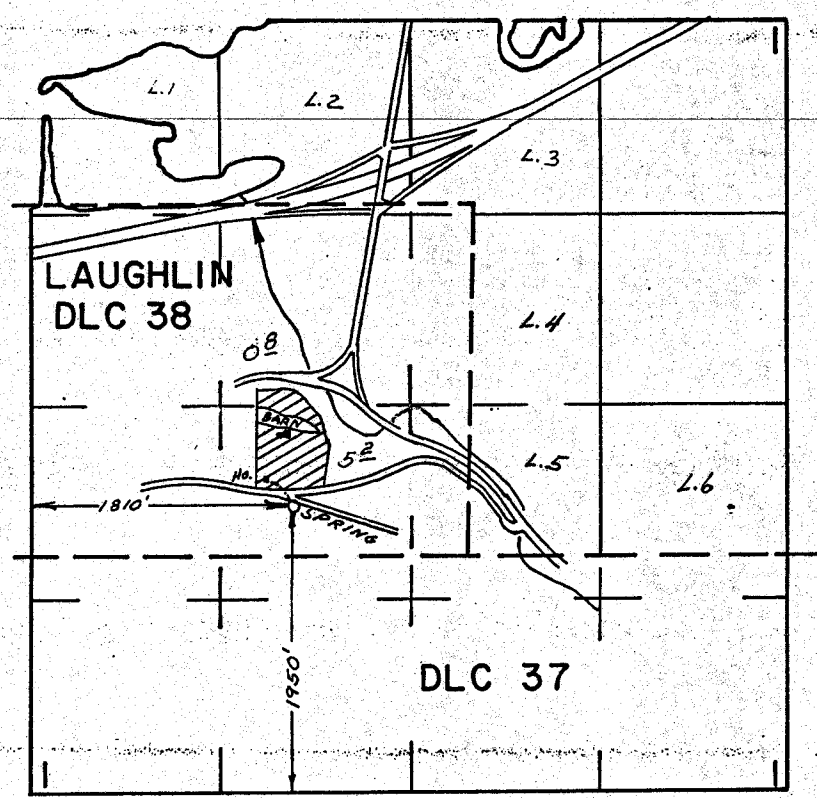

FINAL PROOF SURVEY UNDER

Application No. 52913..... Permit No. 39185.....
IN NAME OF

JERRY O. BOOTH

Surveyed NOV. 2... 1977., by L.H. NUNN.....