


P-40055  
47874

# T.6S., R.19E., W.M.

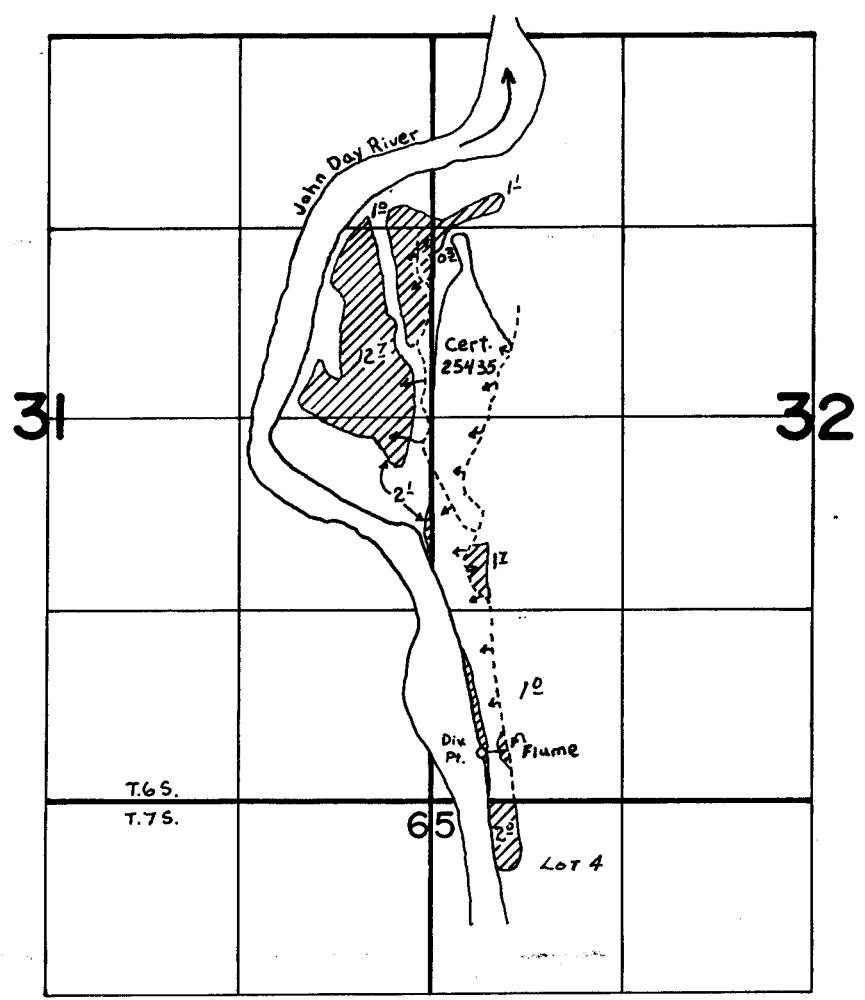

Div. Pt. Located: 320' N & 360' E from the S.W. cor. Sec. 32

## FINAL PROOF SURVEY UNDER

Application No. 53513 Permit No. 40055  
IN NAME OF  
STEIWER RANCHES, INC.  
Surveyed AUG. 25 1976 by D. NORBY