


# T.3S. R.3W., W.M.

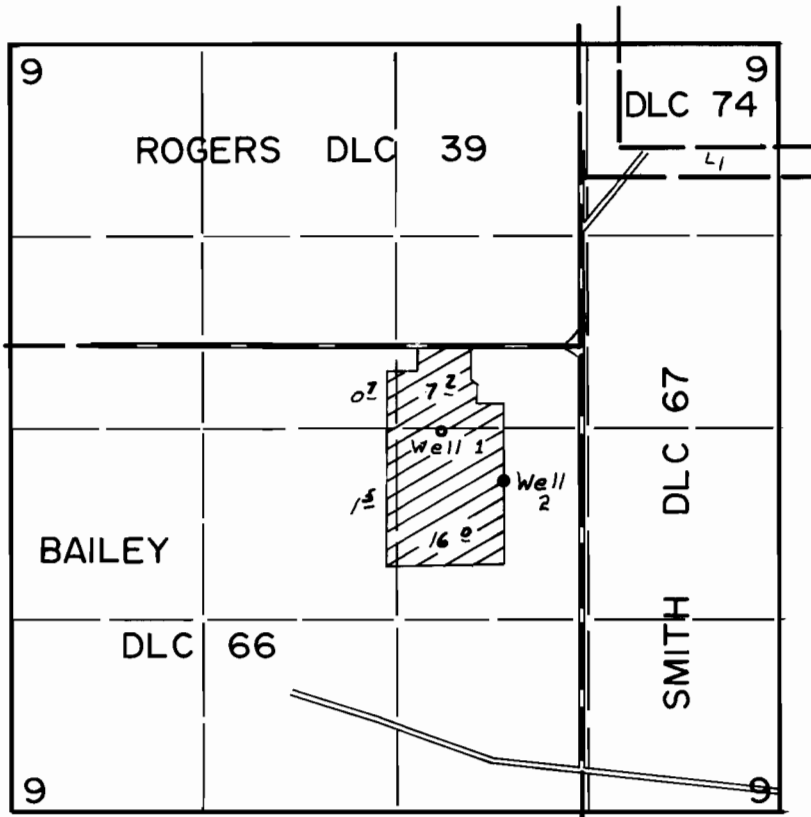

Well 1 - 590' S. & 960' W.; Well 2 - 930' S. & 530' W. Both From N.E. Cor. Bailey DLC 66.

## FINAL PROOF SURVEY UNDER

Application No. G-6989.. Permit No. G-6495..  
IN NAME OF

HARLIN M. HUFFMAN

Surveyed OCT. 5. 1977. by L.H. NUNN