


T.3S. R.4W. W.M.

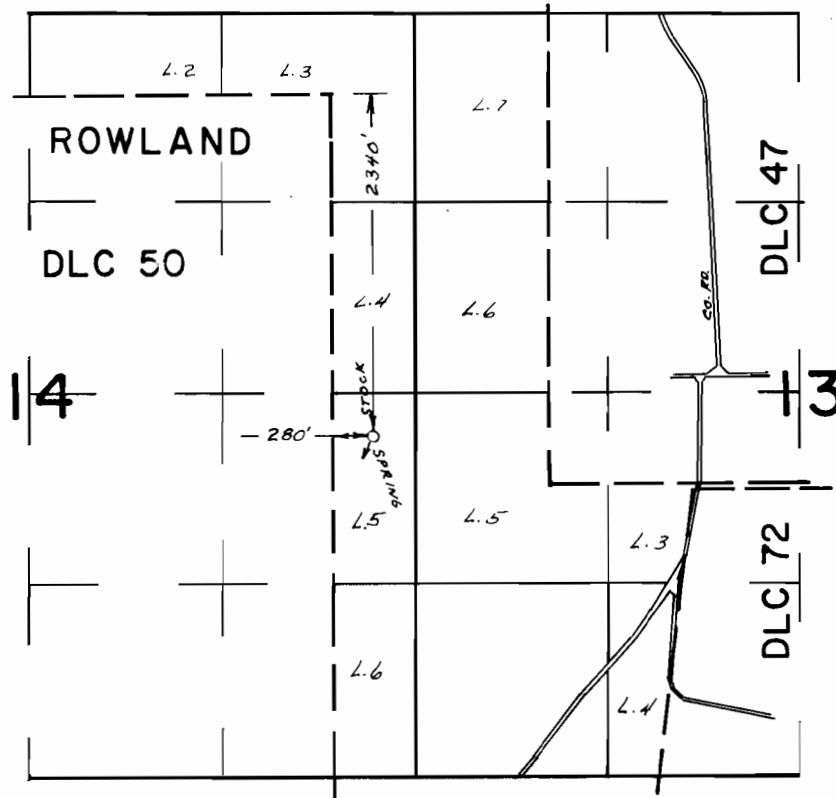

FINAL PROOF SURVEY
UNDER

Application No. 48859... Permit No. 36611...
IN NAME OF

ERVIN E. & MARGUERITE L. BRISCOE

Surveyed OCT. 7... 1977, by L.H. NUNN...