


T.4S. R.5W. W.M.

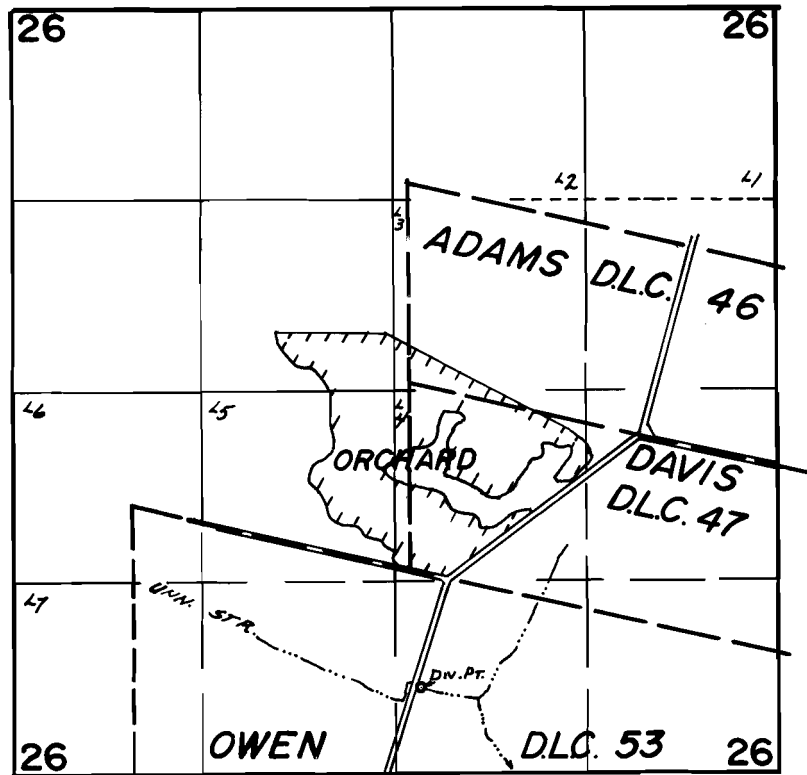

Div. Pt. - 580' N. & 170' E from S 1/4 Cor. Sec. 26

FINAL PROOF SURVEY
UNDER

Application No. 53047 Permit No. 40032
IN NAME OF

LUTHER A. WHITE

Surveyed SEPT. 9 1977. by L.H.NUNN