


T.2S. R.3W. W.M.

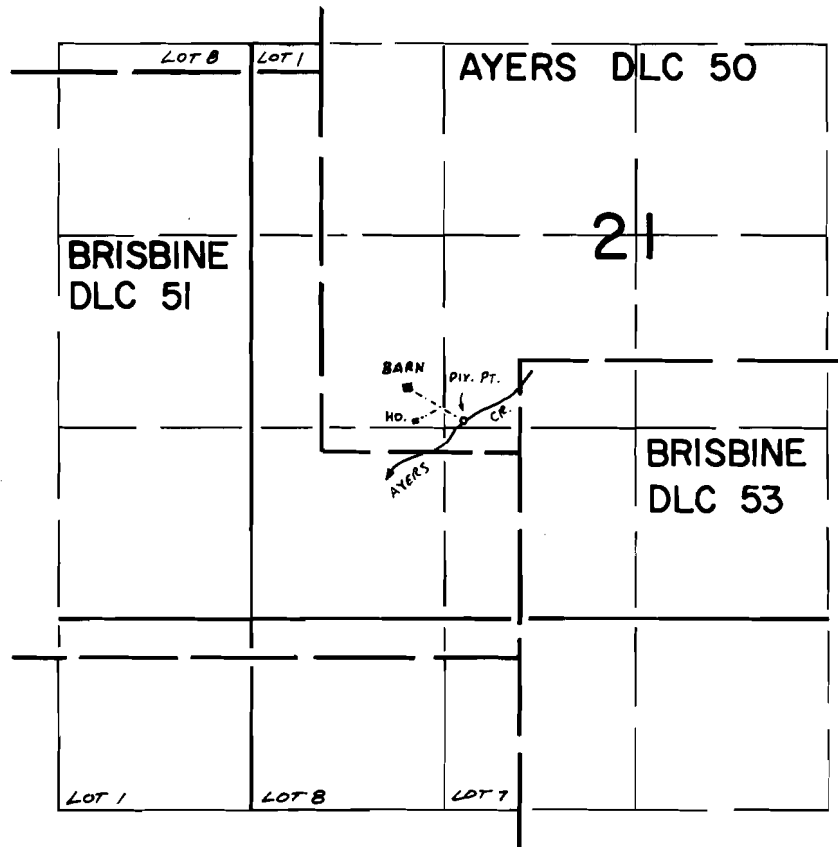

DIV. PT. LOC. 220' N & 1000' E FROM SW COR DLC 50

FINAL PROOF SURVEY
UNDER

Application No. 54118..... Permit No. 40438.....
IN NAME OF

LAURENS CORNELIS & ROSE MARIE DRIESSEN

Surveyed MAY 3..... 1977, by DAVE NORBY.....