


T.2 & 3 S. R.2 W. W.M.

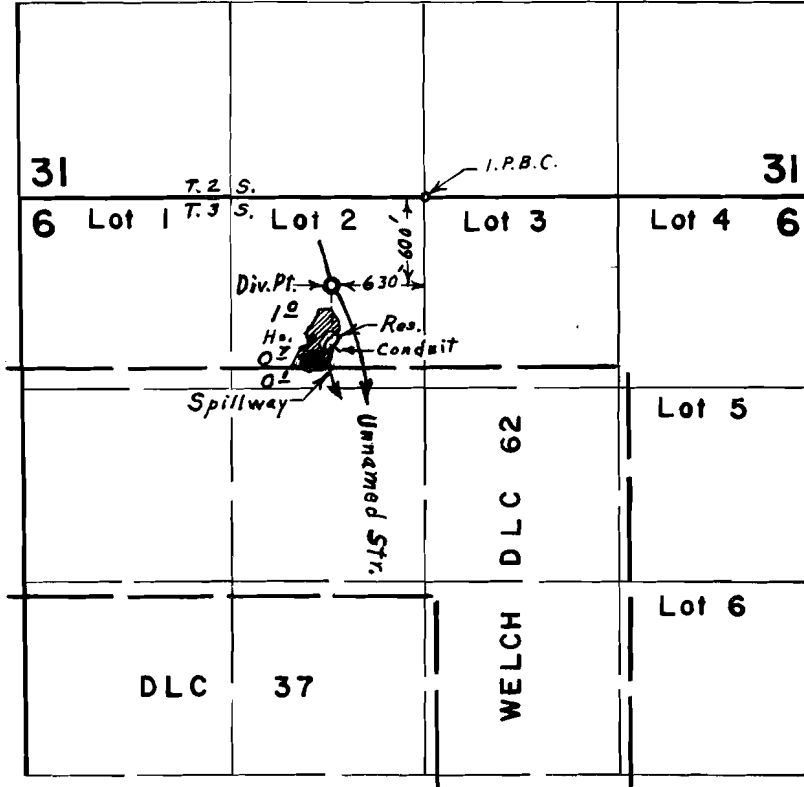

This App -

FINAL PROOF SURVEY
UNDER

RECEIVED

AUG 11 1976

WATER RESOURCES DEPT
SALEM, OREGON

R-45814 R-5398
Application No. ~~45493~~ Permit No. ~~34022~~
IN NAME OF

DONALD W. VERLEY

Surveyed March 27, 1973, by L. E. Gould.

Application No. 54642
Permit No. 41004