


T3S, R1E, WM

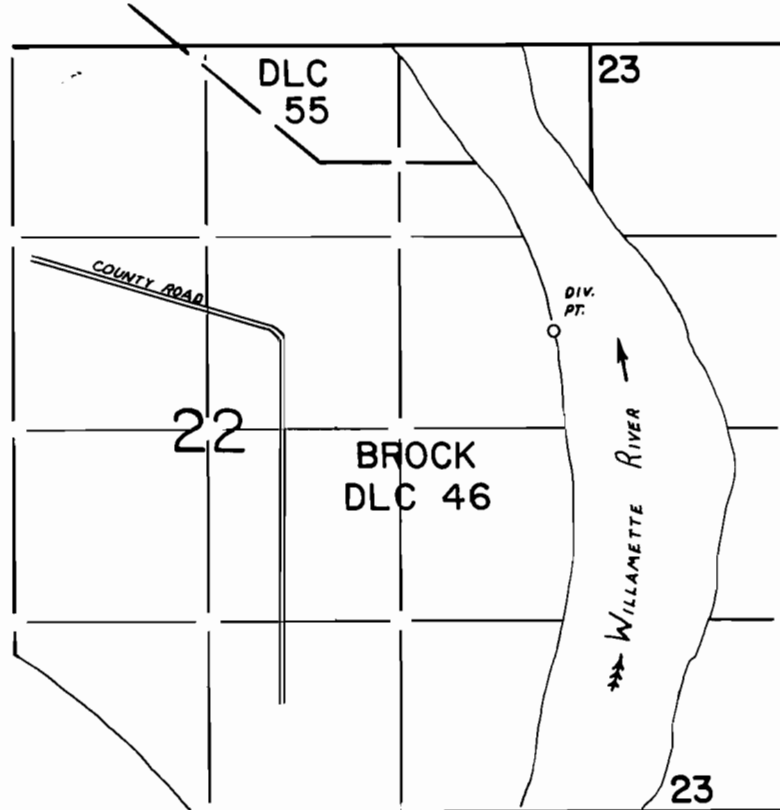

DIV. PT. LOCATED: 3340 FT N & 2325 E FROM S 1/4 CORNER SECTION 22

FINAL PROOF SURVEY UNDER

Transfer No.5823.....
 Application No. Permit No.
 IN NAME OF

.....GARNET PANKEY.....

Surveyed JULY...22... 1987., by T.M. WARREN.....