


T.24&25S.,R.12W.,W.M.

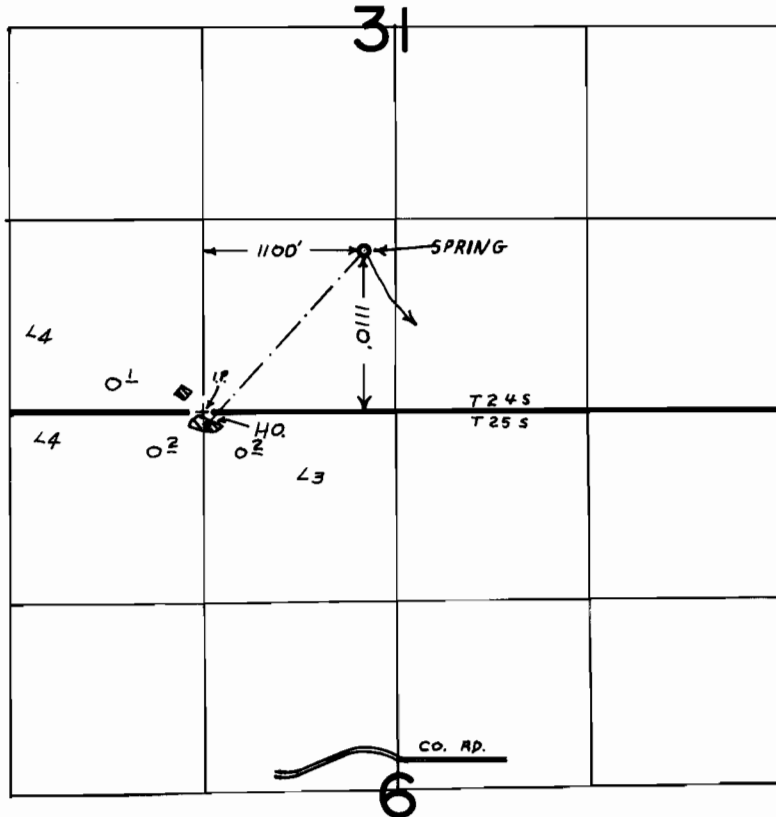

FINAL PROOF SURVEY
UNDER

Application No. 50524..... Permit No. 38151.....
IN NAME OF

..... DANIEL MICKEL LYNCH

Surveyed JUL. 28, 1977, by D.M. NORBY.....