


T.20S. R.18E. W.M.

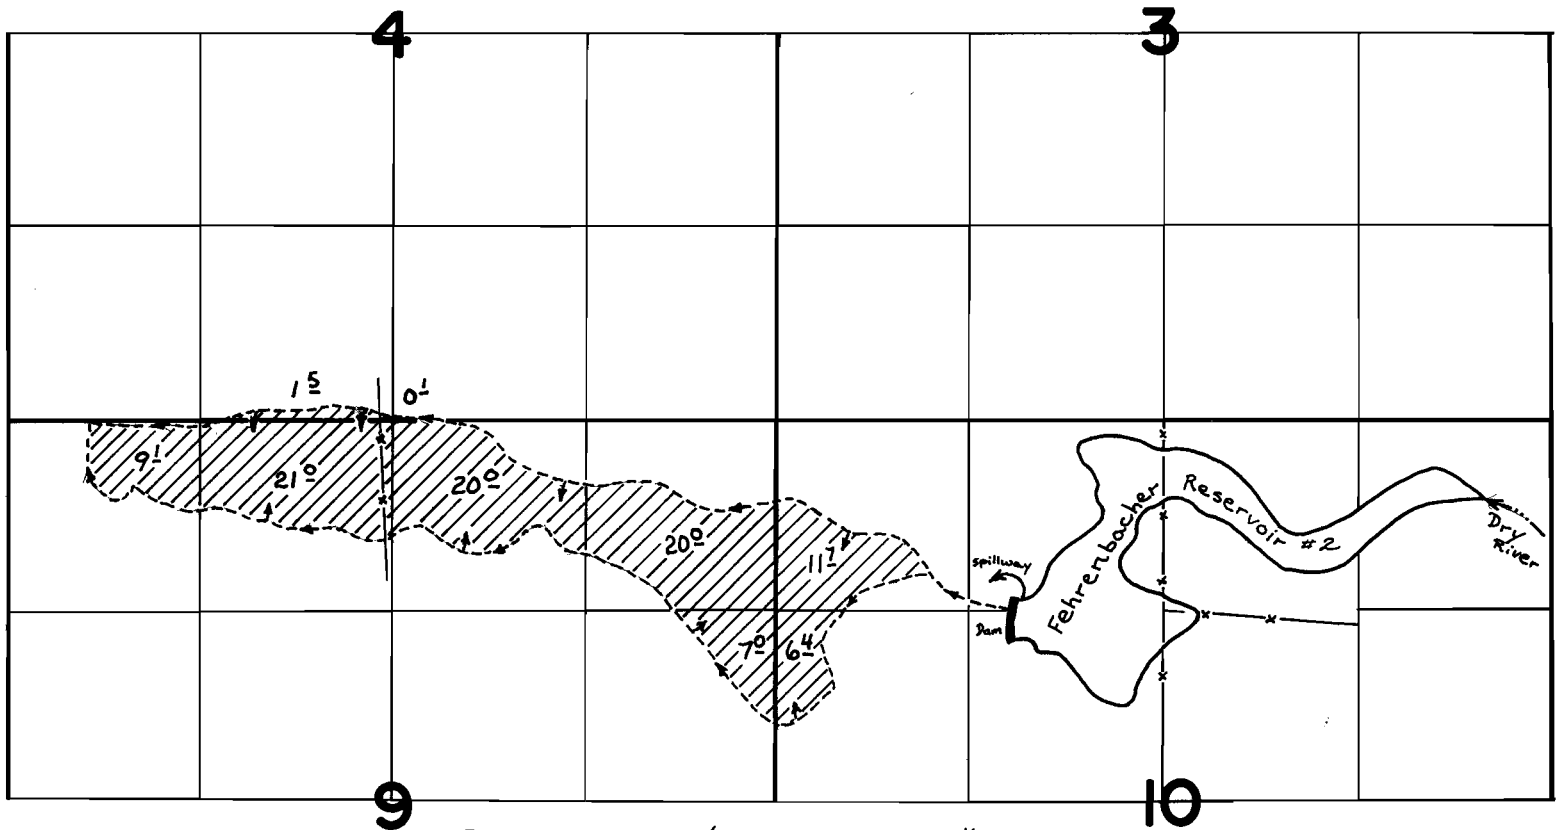

Dam Located: 1050' W from SE cor NE $\frac{1}{4}$ NW $\frac{1}{4}$ Sec. 10

FINAL PROOF SURVEY

UNDER

R-33053

R-2249

33054

26219

R-41597

R-4681

Application No. 41598 Permit No. 31026

IN NAME OF

LEO W. FEHRENBACHER

Surveyed SEPT. 2 1977, by D. NORBY