


T.22S. R.8W. W.M.

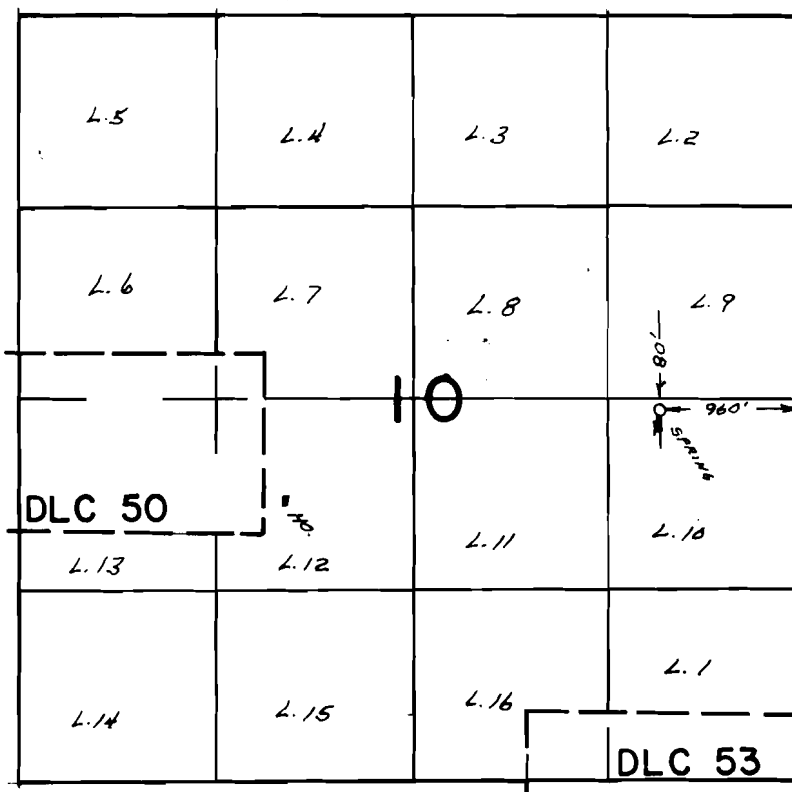

FINAL PROOF SURVEY UNDER

Application No. 53463... Permit No. 39775...
IN NAME OF

GEORGE VANT ZET

Surveyed APR. 20. 1977., by L.H. NUNN