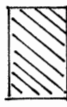



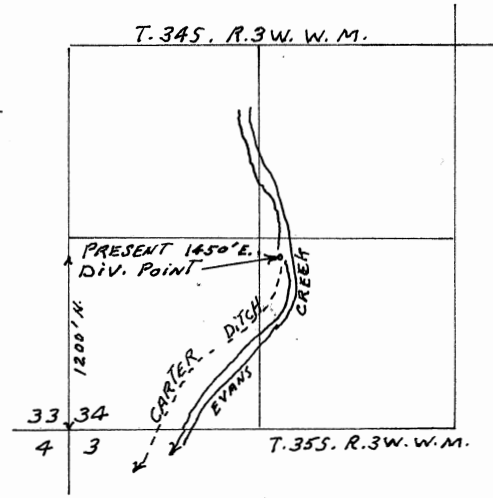
SCALE 1" = 400'

RECEIVED
 JUL 29 1974
 STATE ENGINEER
 SALEM, OREGON

 CHANGE IN POINT OF DIVERSION ONLY

 CHANGE IN PLACE OF USE AND POINT OF DIVERSION

 PROPOSED PLACE OF USE



SCALE 4" = 1 MILE



MAP TO ACCOMPANY APPLICATION OF
 REASON D. EVENSIZER FOR
 CHANGE IN POINT OF DIVERSION AND
 CHANGE IN PLACE OF USE

7-12-74

T-3104