


6-4119
47916

T36837S. R.14815E., W.M.

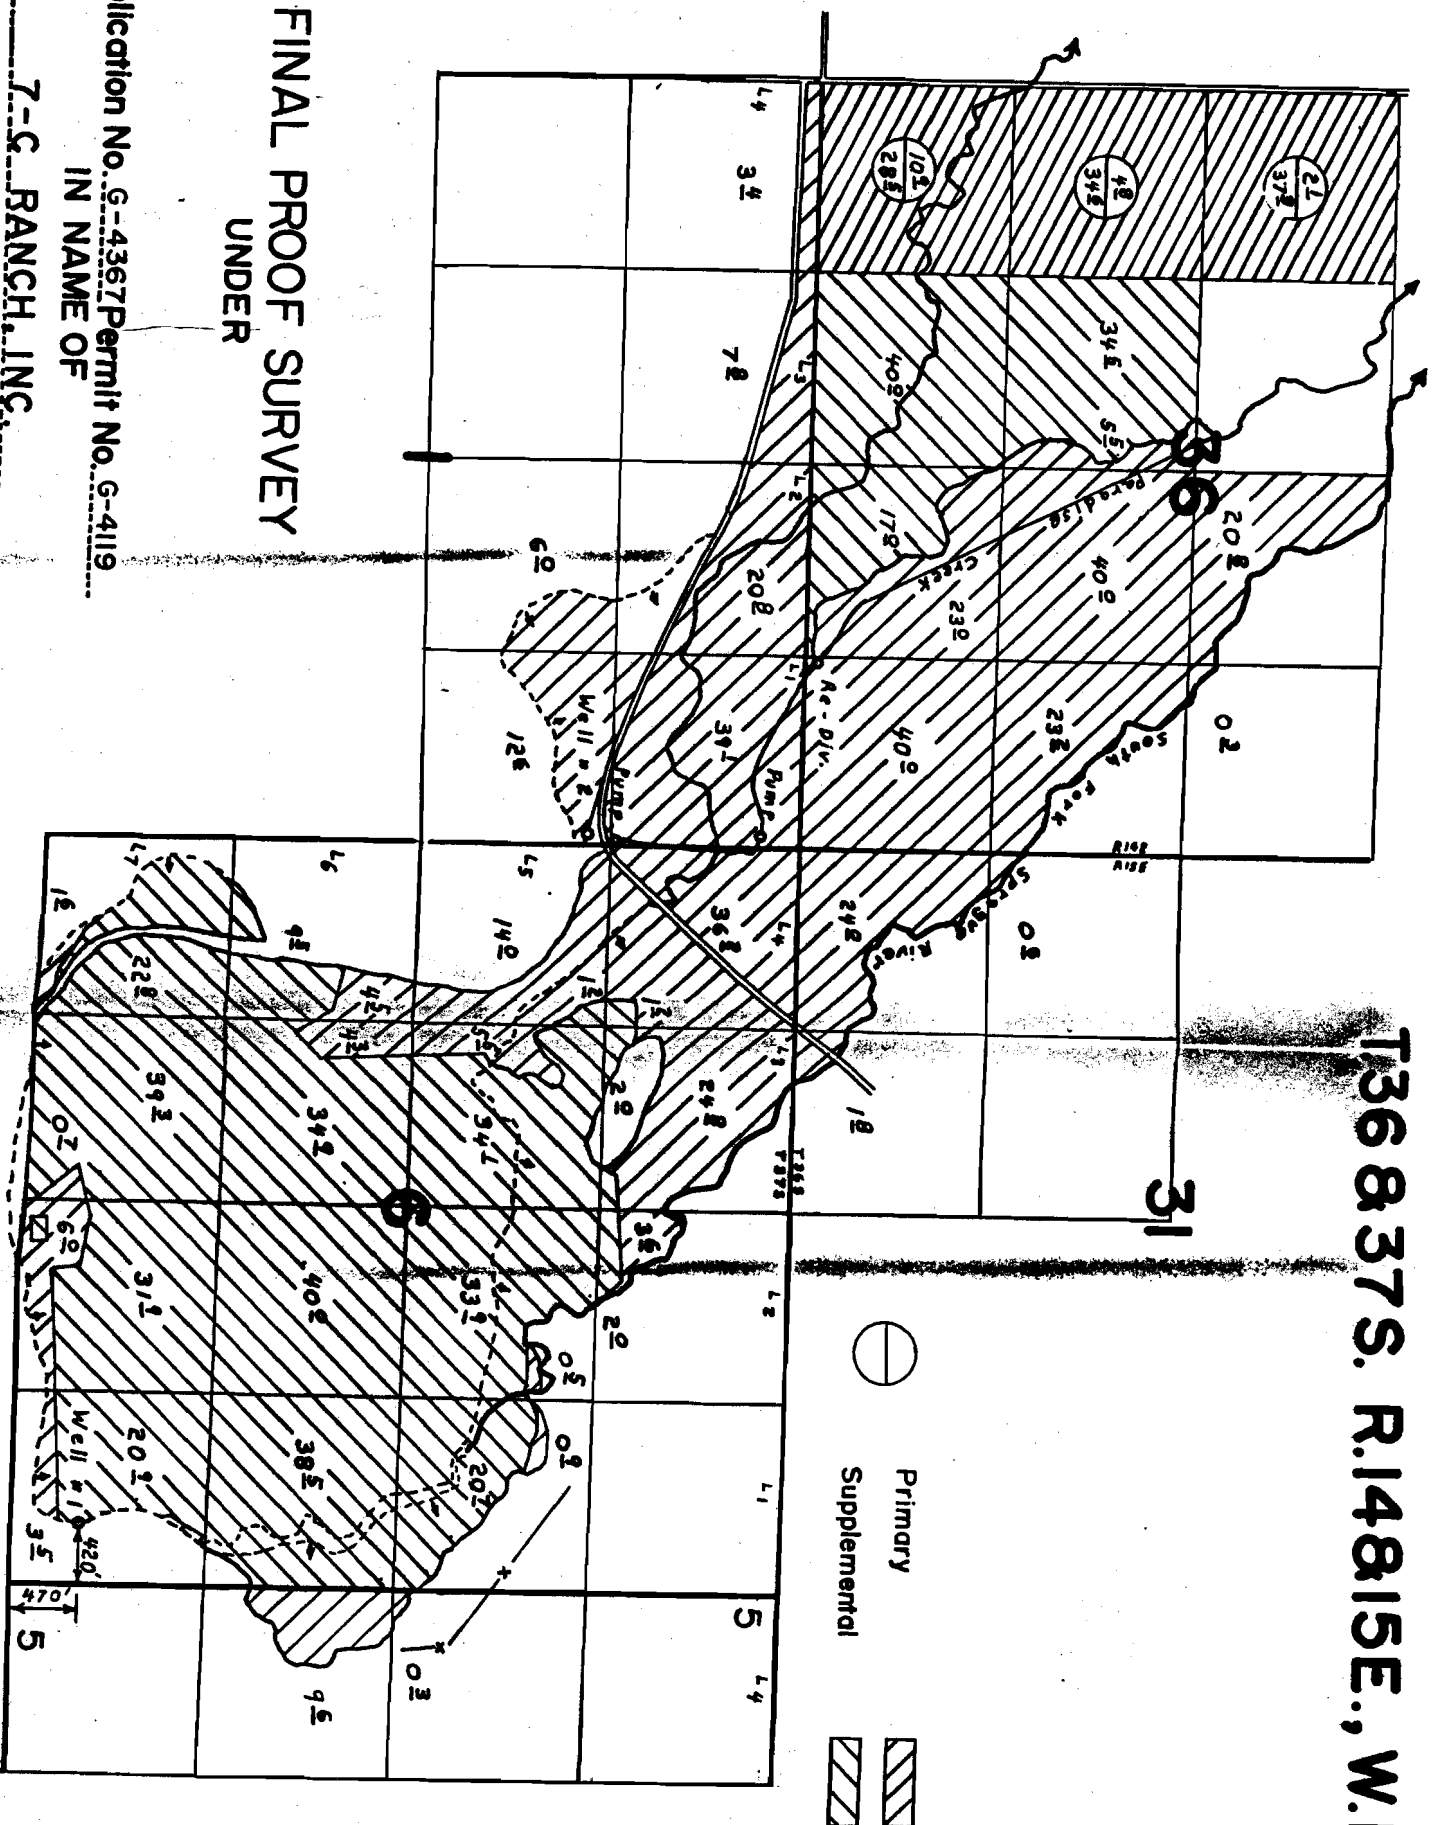

FINAL PROOF SURVEY
UNDER

Application No. G-4367 Permit No. G-4119
IN NAME OF

7-C RANCH, INC.

Surveyed AUG 22 1977, by D. M. NORBY

See Spgs. B. 75 S.