


G-5999
47919

T. 27S. R. 15E., W.M.

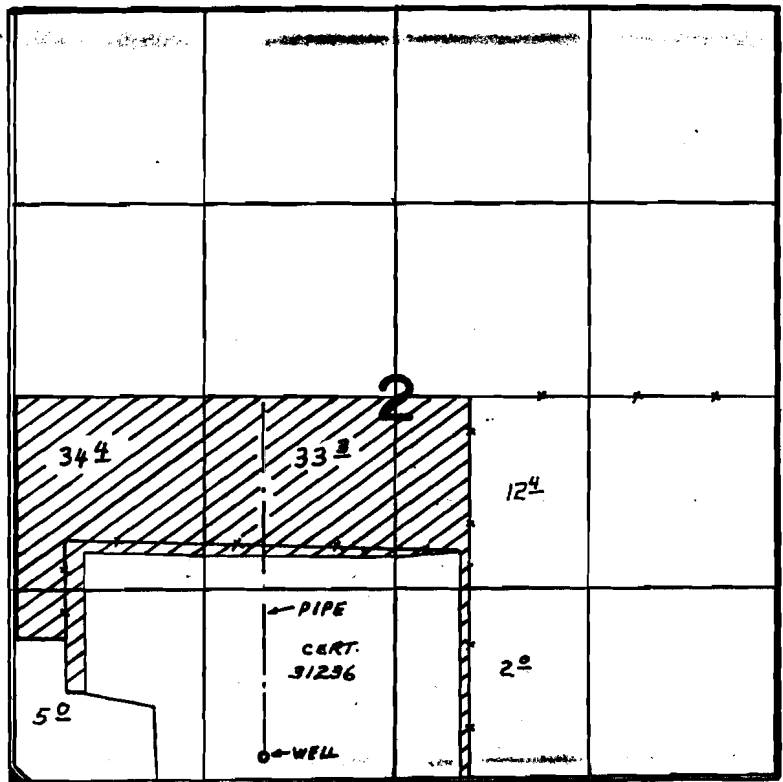

WELL LOC. 1730' E. & 170' N. FROM S.W. COR. SEC. 2

FINAL PROOF SURVEY UNDER

Application No. G-6433 Permit No. G-5999
IN NAME OF

HAROLD A. & LOIS MILES

Surveyed JUL 18, 1977, by D.M. NORBY

CNR-1KK-95

ecf