


T39S. R19E. WM.

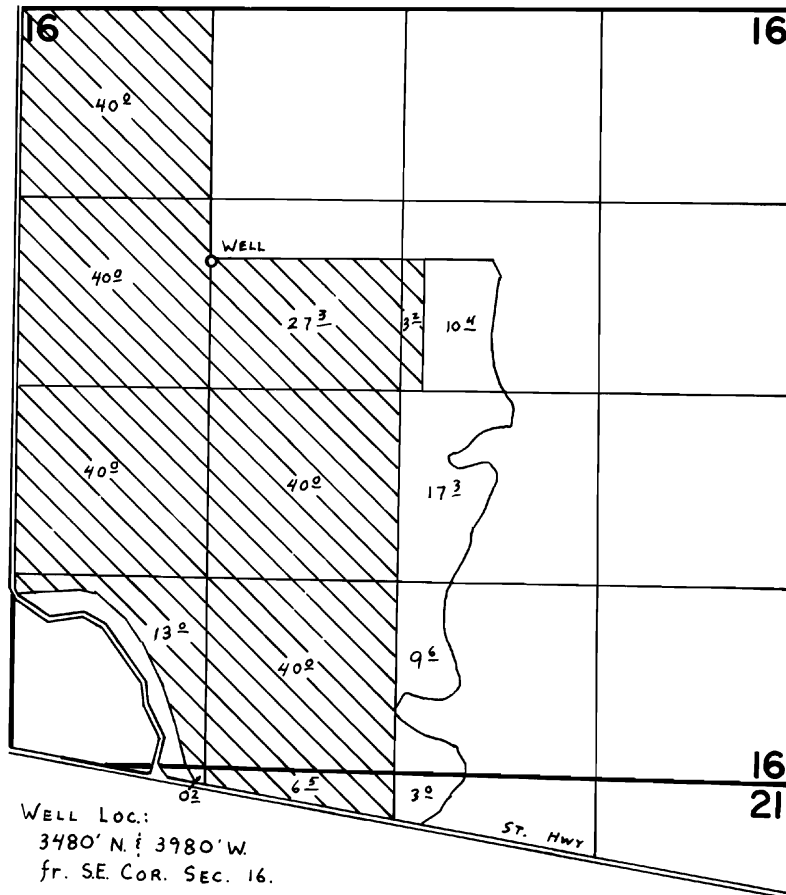

FINAL PROOF SURVEY UNDER

Application No. G-7137 Permit No. G-6587
IN NAME OF

MATTHEW L. OUTLAND

Surveyed JUNE 23 1978, by C. L. HUGHES