


P: 3758
47923

T39S. R19E. WM.

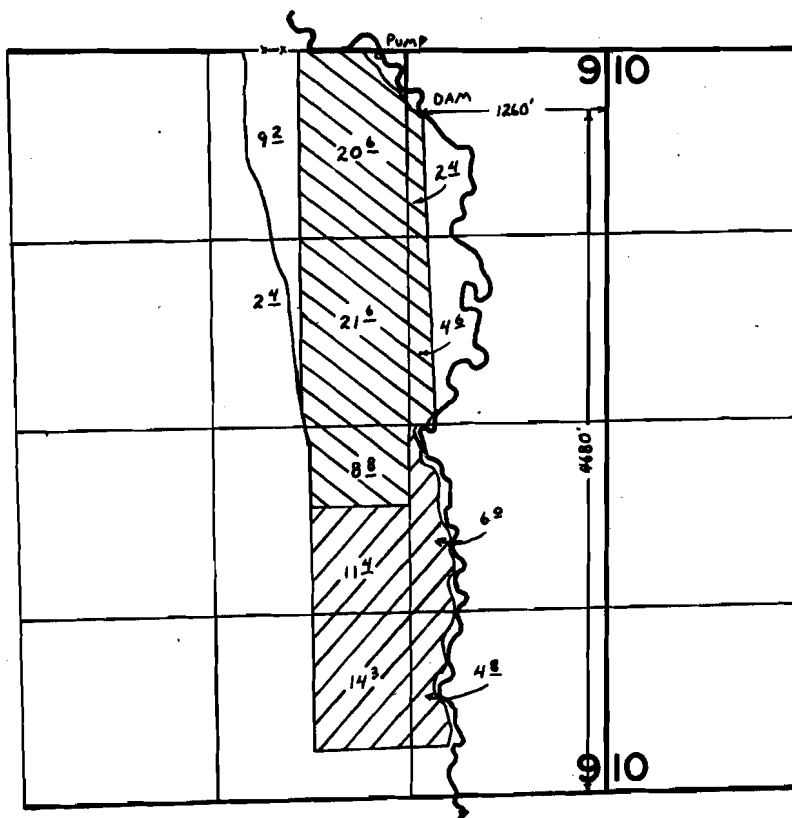

FINAL PROOF SURVEY UNDER

T-3330 
Transfer No T-3331 
Application No. Permit No.
IN NAME OF

MATTHEW L. OUTLAND

Surveyed JUNE 23 1978, by C.L. HUGHES