


T19S. R11W. WM.

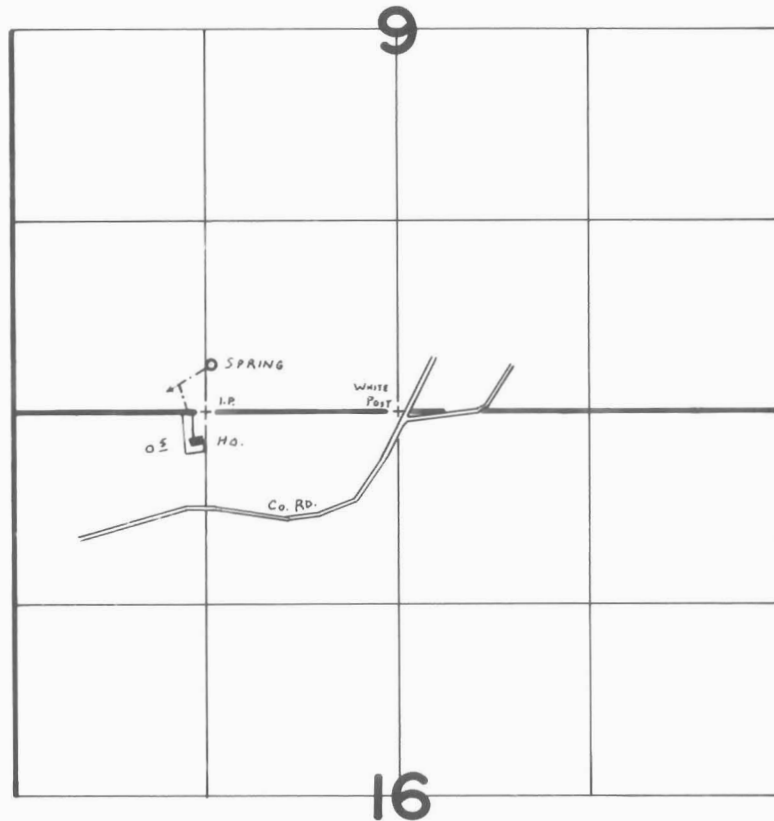

SPRING Loc: 320' N. & 30' E. fr. SW. COR. of S.E. 1/4 S.W. 1/4 SEC. 9.

FINAL PROOF SURVEY UNDER

Application No. 46199 Permit No. 34518
IN NAME OF

GLEN & VERLA AUSTIN.....

Surveyed JULY 26 1978, by C. L. HUGHES.....