


T.18S. R.IIW., W.M.

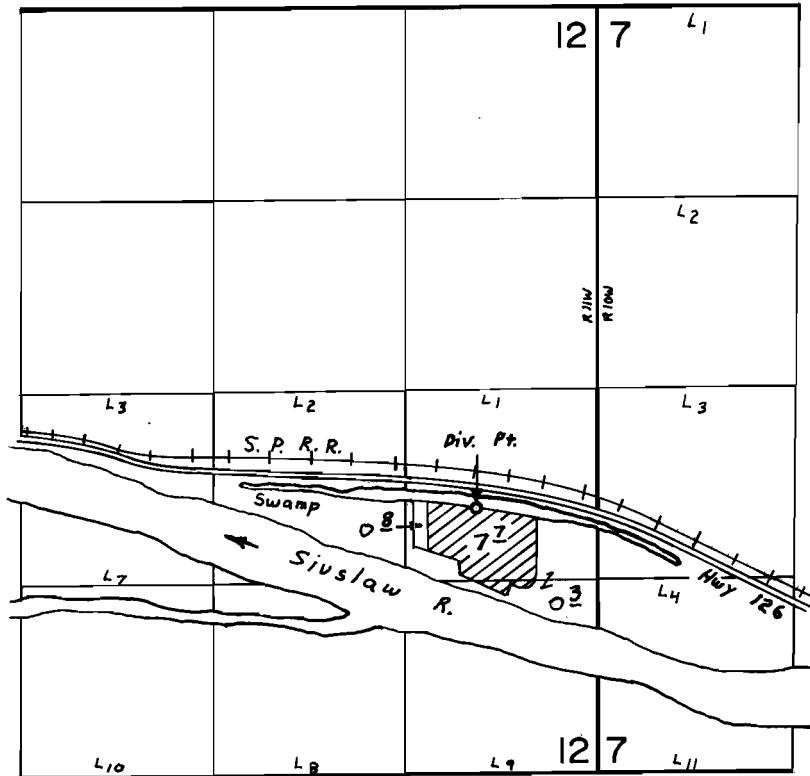

Div. Pt. Loc. 1820' N. & 820' W. From S.E. Cor. Sec. 12

FINAL PROOF SURVEY UNDER

Application No. 50238... Permit No. 37927...
IN NAME OF

.....GORDON E. KOHLER.....

Surveyed AUG. 26. 1977, by B.R. SUND.....