


T.17S. R.1E. W.M.

SEC. 10

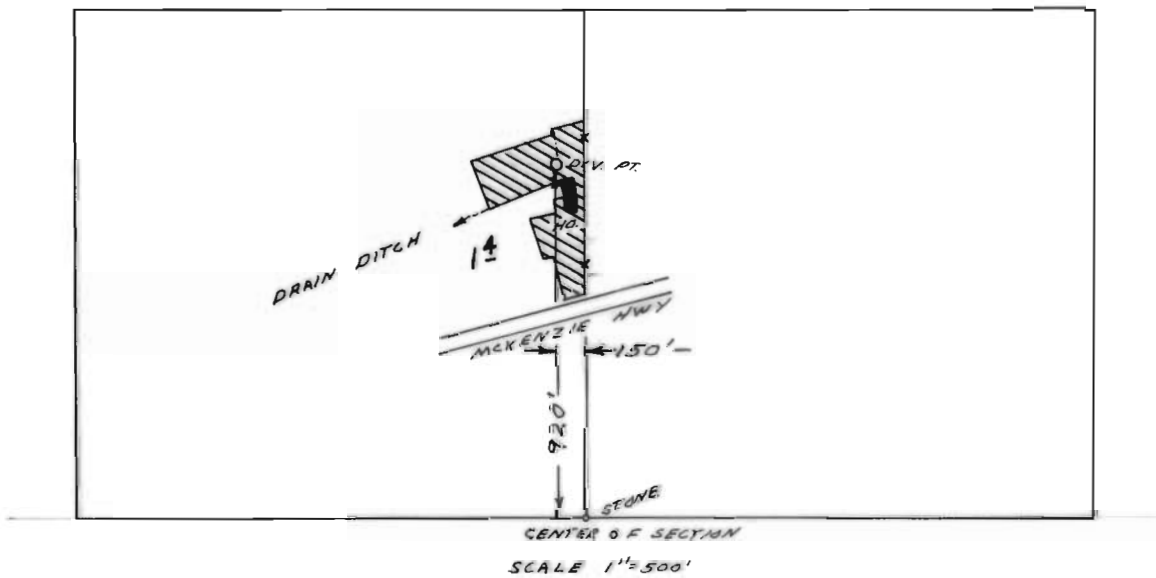

FINAL PROOF SURVEY
UNDER

Application No. 51748..... Permit No. 37476.....
IN NAME OF

J. GORDON & JEANNETTE E. VANCE.....

Surveyed SEP. 1, 1977, by L.H. NUNN.....