


T.IIS. R.IIW. W.M.

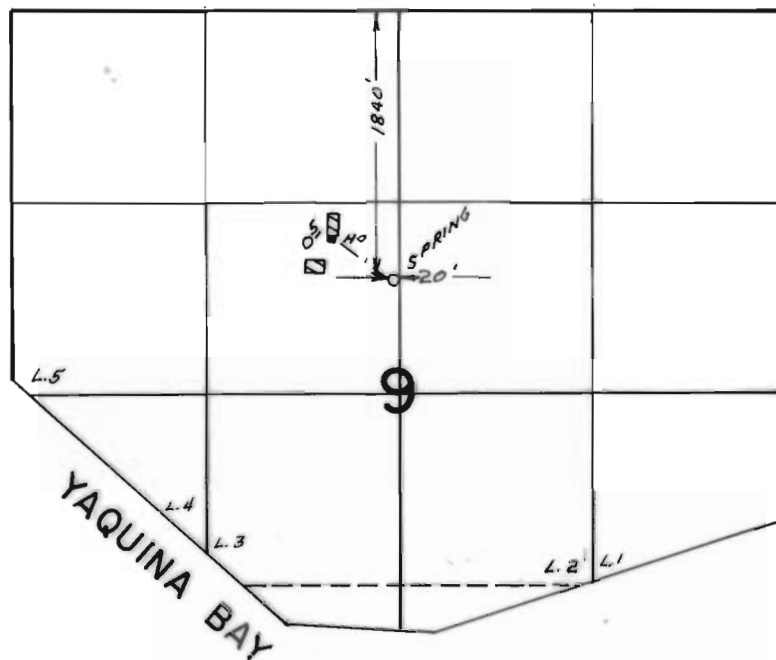

FINAL PROOF SURVEY
UNDER

Application No. 51651..... Permit No. 38947....
IN NAME OF

VICTOR & CLARE E. BUMP

Surveyed SEP 30, 1977, by LH NUNN.....