


# T.14S. R.11W., W.M.

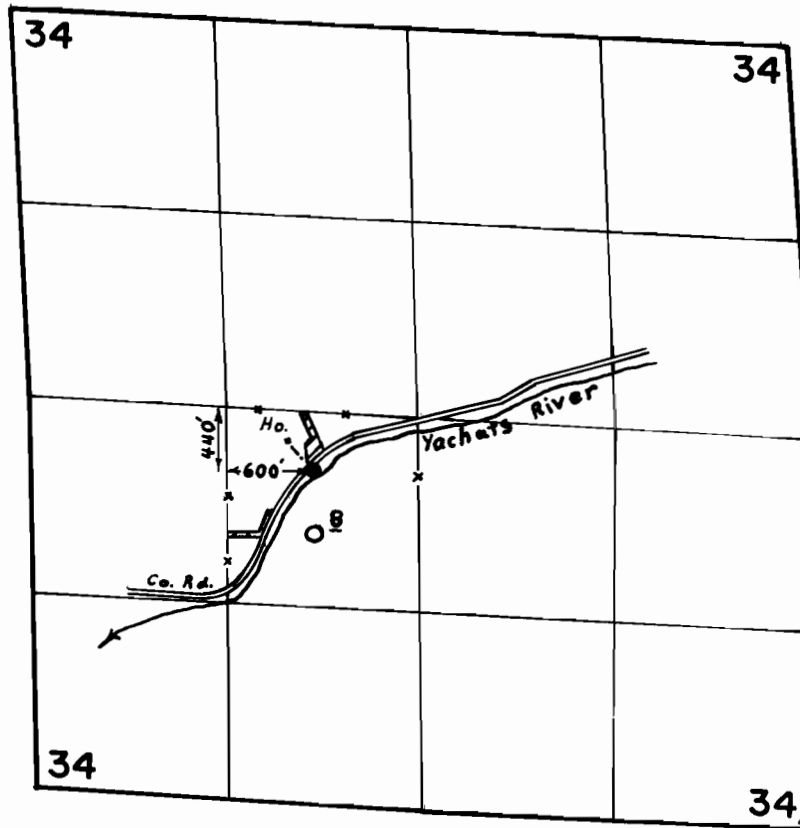

## FINAL PROOF SURVEY UNDER

Application No. 51946... Permit No. 37443...  
IN NAME OF

.....RICHARD L. BAKER.....

Surveyed SEP. 27. 1977., by L.H. NUNN.....