


T. 7 S., R. 2 W., W.M.

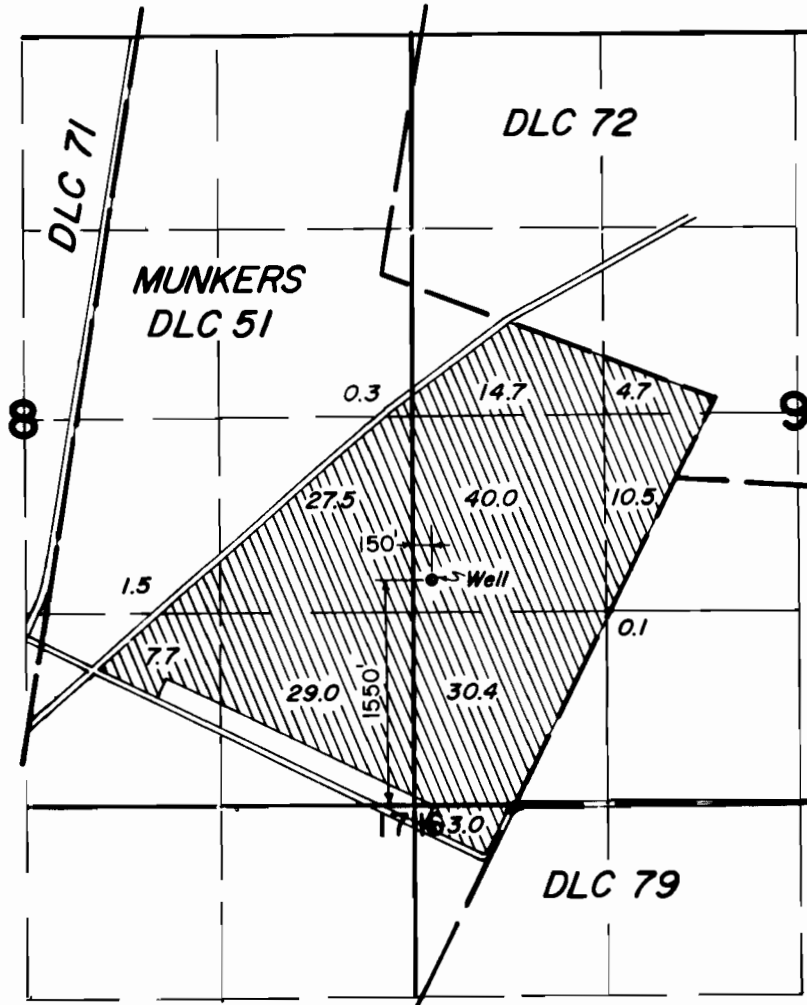

FINAL PROOF SURVEY UNDER

Application No. G 6249 Permit No. G 5891
IN NAME OF

JOE DITCHEN FARMS

Surveyed APR. 13, 1977, by L. H. NUNN

MB