


T.5S. R.2W., W.M.

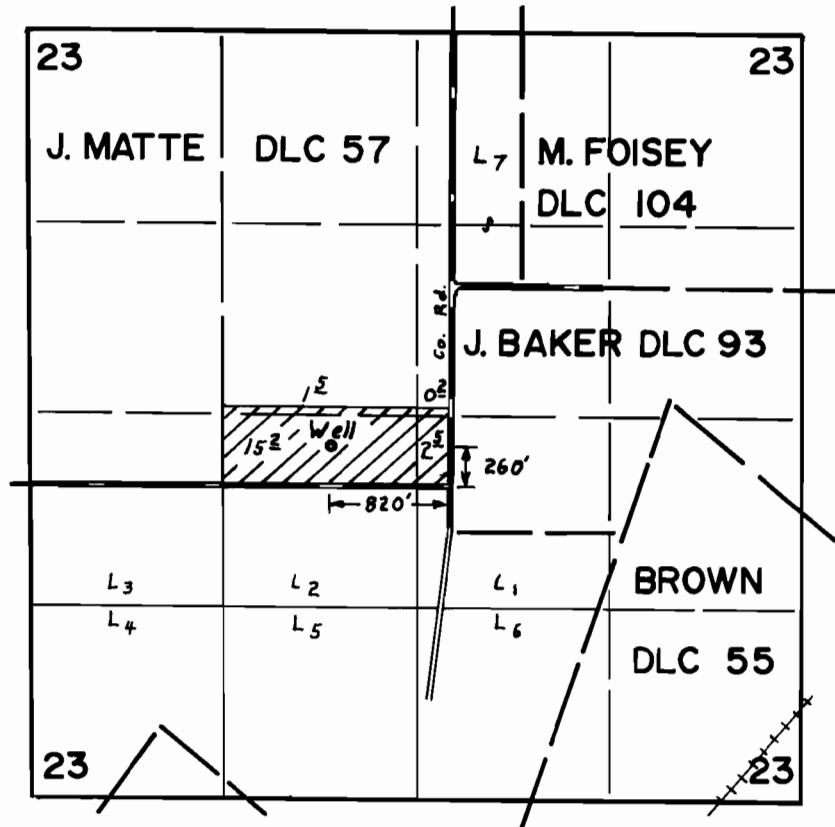

FINAL PROOF SURVEY UNDER

Application No. G-6564. Permit No. G-6165...
IN NAME OF

.....LEONA E. JOHNSON.....

Surveyed SEP...8.. 1977., by B.R. SUND.....